


15-077-30137-0000

Give All Information Completely  
Make Required Affidavit  
Mail or Deliver Report to:  
Conservation Division  
State Corporation Commission  
211 No. Broadway  
Wichita, Kansas

WELL PLUGGING RECORD

NORTH

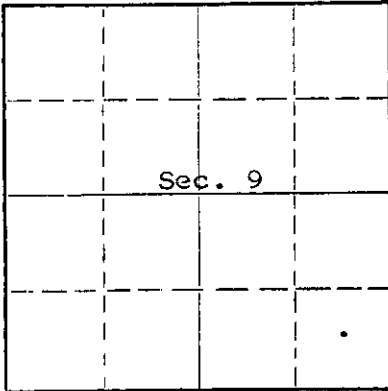

Locate well correctly on above  
Section Plat

Harper County, Sec. 9 Twp. 31w Rge. 6(W) NE SE  
Location as "NE/CNW/SW" or footage from lines C SE SE  
Lease Owner Petroleum, Inc.,  
Lease Name Wohlschlegel Well No. 1  
Office Address Route #2, Great Bend, Kansas  
Character of Well (completed as Oil, Gas or Dry Hole) dry hole  
Date well completed February 4 19 65  
Application for plugging filed February 16 19 65  
Application for plugging approved February 17 19 65  
Plugging commenced February 17 19 65  
Plugging completed February 20 19 65  
Reason for abandonment of well or producing formation no producible zones

If a producing well is abandoned, date of last production - 19  
Was permission obtained from the Conservation Division or its agents before plugging was commenced? yes

Name of Conservation Agent who supervised plugging of this well Archie Elving, Box 248, Pratt, Kansas  
Producing formation mississippi Depth to top 4300' Bottom 4554' Total Depth of Well 4731 Feet  
Show depth and thickness of all water, oil and gas formations.

OIL, GAS OR WATER RECORDS

CASING RECORD

FORMATION	CONTENT	FROM	TO	SIZE	PUL IN	PULLED OUT
mississippi	small amount of gas, water & oil	4308	4316	8-5/8"	216'	none
				5-1/2"	4430'	3851.69

Describe in detail the manner in which the well was plugged, indicating where the mud fluid was placed and the method or methods used in introducing it into the hole. If cement or other plugs were used, state the character of same and depth placed, from \_\_\_\_\_ feet to \_\_\_\_\_ feet for each plug set.  
( plugged back total depth 4365' )

2-4-65 - pumped in 25 sacks mud. set a cast iron bridge plug at 4290' with a wire line.

2-17-65 - Southwest Casing Pulling Company, Inc. commenced plugging well. Mudded up with heavy mud to 235', followed by a 10' rock bridge, mixed and ran 25 sacks cement through dump bailer. Mudded up with heavy mud to 40', followed by a 10' rock bridge. Mixed and dumped 10 sacks cement to base of well cellar.

RECEIVED  
STATE CORPORATION COMMISSION

MAR 1 1965  
3-1-65  
CONSERVATION DIVISION  
Wichita, Kansas

(If additional description is necessary, use BACK of this sheet)

Name of Plugging Contractor Southwest Casing Pulling Co., Inc.  
Address Box 364, Great Bend, Kansas

STATE OF Kansas, COUNTY OF Barton, ss.  
Monte Chadd (employee of owner) or (owner or operator) of the above-described well, being first duly sworn on oath, says: That I have knowledge of the facts, statements, and matters herein contained and the log of the above-described well as filed and that the same are true and correct. So help me God. Monte Chadd, Dist. Prod. Supt.  
(Signature) *Monte Chadd*  
Route #2, Great Bend, Kansas  
(Address)

SUBSCRIBED AND SWORN to before me this 24 day of February, 19 65

My commission expires October 19, 1968

Notary Public.

15-077-30137-0000  
WELL LOG

COMPANY Petroleum, Inc.

SEC. 9 T. 31S R. 6W

FARM Wohlschlegel NO. 1


LOC. SE SF

TOTAL DEPTH 4731'

COUNTY Harper

COMM. 12-11-64 COMP. 12-29-64

CONTRACTOR Garvey Drilling Company

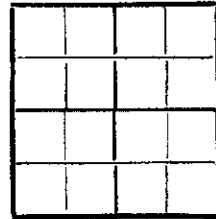

CASING 8 5/8" @ 216' w/185 sx  
5 1/2" @ 4430' w/100 sx

ELEVATION 1494' DF

PRODUCTION

FIGURES INDICATE BOTTOM OF FORMATIONS

500' Red Bed  
1150' Shale and Shells  
1200' Shale and Lime  
1230' Lime and Shale  
1435' Lime  
1781' Lime and Shale  
1825' Lime  
2080' Lime and Shale  
3130' Shale and Lime  
3750' Lime and Shale  
4345' Lime  
4370' Chert  
4448' Cherty Lime  
4473' Lime  
4582' Lime and Chert  
4619' Cherty, Shale and Lime  
4660' Shale and Lime  
4720' Shale, Lime, and Sand  
4730' Shale and Lime  
4731' Sand  
4731' BTD

RECEIVED  
STATE CORPORATION COMMISSION

MAR 1 1965  
3-1-65  
CONSERVATION DIVISION  
Wichita, Kansas

State of Kansas }  
County of Barton } ss

I, Sam N. Stephens of Garvey Drilling Company

upon oath state the above and foregoing is a true and correct copy of the log of the Wohlschlegel #1 well.

*Sam N. Stephens*

Subscribed and sworn to before me this 4th day of January 19 65

My Commission Expires: October 19th, 1968

*David L. Johnson*  
NOTARY PUBLIC