


STATE OF KANSAS
STATE CORPORATION COMMISSION

WELL PLUGGING RECORD

Give All Information Completely
Make Required Affidavit
Mail or Deliver Report to:
Conservation Division
State Corporation Commission
800 Bittling Building
Wichita, Kansas

NORTH

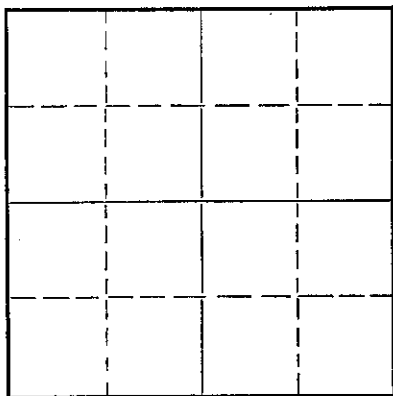

Locate well correctly on above
Section Plat

Harper County, Sec. 10 Twp. 31 Rge. 6 (E) (W)
Location as "NE/CNW/SW" or footage from lines. N W Sw, N E
Lease Owner Mull Drilling Company Inc.
Lease Name L. Stevens Well No. 1
Office Address 6405 E. Kellogg, Wichita, Kansas
Character of Well (completed as Oil, Gas or Dry Hole) Dry Hole
Date well completed 4-4-57 19
Application for plugging filed 4-4-57 19
Application for plugging approved 4-4-57 19
Plugging commenced 4-4-57 19
Plugging completed 4-4-47 19
Reason for abandonment of well or producing formation Dry Hole

If a producing well is abandoned, date of last production. None 19
Was permission obtained from the Conservation Division or its agents before plugging was commenced? Yes

Name of Conservation Agent who supervised plugging of this well Mr. Rives
Producing formation None Depth to top None Bottom none Total Depth of Well 4672 Feet
Show depth and thickness of all water, oil and gas formations.

OIL, GAS OR WATER RECORDS

CASING RECORD

FORMATION	CONTENT	FROM	TO	SIZE	PUT IN	PULLED OUT
				8 5/8	200 ft	none

Describe in detail the manner in which the well was plugged, indicating where the mud fluid was placed and the method or methods used in introducing it into the hole. If cement or other plugs were used, state the character of same and depth placed, from _____ feet to _____ feet for each plug set.

Hole was filled with heavy rotary mud. From total depth back to 200 feet. Plugged set at 200 feet. 20 sacks of cement on top of plug. Mud on top of cement. Plug set at 40 feet, with 10 sacks of cement on top. Surface pipe cut off three feet below surface. Cement was filled up to the bottom of cellar. Cement was mixed and put in well through drill pipe.

(If additional description is necessary, use BACK of this sheet)

Name of Plugging Contractor Company Tools
Address Wichita, Kansas

STATE OF Kansas, COUNTY OF Harper, ss.
O. C. Arnott (employee of owner) or (owner or operator) of the above-described well, being first duly sworn on oath, says: That I have knowledge of the facts, statements, and matters herein contained and the log of the above-described well as filed and that the same are true and correct. So help me God.

(Signature) *O. C. Arnott*
(Address) *Harper*

SUBSCRIBED AND SWORN to before me this 6th day of April, 1957

My commission expires 1-7-61

[Signature]
Notary Public.

PLUGGING
FILE SEC 10 T 31 R 6W
FOUR PAGE 4 LINE 17

APR 8 - 1957
4-8-57
CONSERVATION DIVISION
Wichita, Kansas

ROTARY DRILLERS LOG

COMPANY : Mull Drilling Co., Inc. ROTARY DRILLING COMMENCED: 3-19-57
 Wichita, Kansas

CONTRACTOR : Mull Drilling Co., Inc. ROTARY DRILLING COMPLETED: 4-4-57
 Wichita, Kansas

CASING RECORD : Set 8 5/8" @ 200' cemented LOCATION: L. L. Stevens #1
 with 125 sacks cement NW SW NE of Sec. 10-31S-6W
 Harper County, Kansas

(Figures indicate bottom of formation - measurements from top of Rotary Bushing)

Red Bed	200
Shale & Red Bed	400
Shale & Shells	1000
Shale	1030
Lime	1300
Lime & Shale	1480
Lime	1775
Lime & Shale	3715
Lime	3780
Lime & Shale	3803
Lime	4114
Lime & Shale	4231
Lime	4527
Lime & Shale	4672' R.T.D. - D & A

I hereby certify that this is a true and correct copy of the above log to the best of my knowledge.

MULL DRILLING CO., INC.

BY *Joseph B. Brungardt, Jr.* Asst. Pres.
 JOSEPH B. BRUNGARDT, JR.

STATE OF KANSAS)
) SS
 COUNTY OF SEDGWICK)

Subscribed and sworn to before me this 11th day of April, 1957



Mable M. Wilson
 NOTARY PUBLIC

EXPIRES: February 24, 1960.

RECEIVED
 STATE CORPORATION COMMISSION
 6-29-57
 JUN 29 1957

CONSERVATION DIVISION
Wichita, Kansas

PLUGGING
 FILE SEC 10 T 31 R 6W
 BOOK PAGE 4 LI 17