


15-077-20404-0000

STATE OF KANSAS  
STATE CORPORATION COMMISSION

WELL PLUGGING RECORD

Give All Information Completely  
Make Required Affidavit  
Mail or Deliver Report to  
Conservation Division  
State Corporation Comm.  
245 North Water  
Wichita, KS 67202

Harper County, Sec. 9 Twp. 31 Rge. 6 E/W  
Location as "NE/CNW/SW" or footage from lines  
760 ESL and 710 EEL  
Lease Owner Texas Oil and Gas Corporation  
Lease Name Wohlschlegel Well No. 1  
Office Address 200 W Douglas, Suite 300, Wichita 67202  
Character of Well (Completed as Oil, Gas or Dry Hole)  
X  
Date Well completed 19  
Application for plugging filed 19  
Application for plugging approved 19  
Plugging commenced July 13 19 78  
Plugging completed July 19 3:15 19 78  
Reason for abandonment of well or producing formation  
Not productive.  
If a producing well is abandoned, date of last production 19

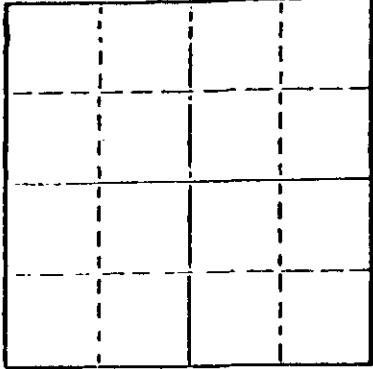

Locate well correctly on above  
Section Plot

Was permission obtained from the Conservation Division or  
its agents before plugging was commenced? Yes

Name of Conservation Agent who supervised plugging of this well Bill Owens  
Producing formation Depth to top Bottom Total Depth of Well 4364  
Show depth and thickness of all water, oil and gas formations.

OIL, GAS OR WATER RECORDS

CASING RECORD

FORMATION	CONTENT	FROM	TO	SIZE	PUT IN	PULLED OUT
				8 5/8	230	NONE
				4 1/2	4348	3477

Describe in detail the manner in which the well was plugged, indicating where the mud fluid  
was placed and the method or methods used in introducing it into the hold. If cement or other  
plugs were used, state the character of same and depth placed, from feet to  
feet for each plug set.

Sand from 4320 to 4288. 4 sacks cement from 4288 to 4258. Ripped at 3477.  
Pulled 4 1/2" Bridge at 300 - Rock from 300 - 2%. 5 yards ready-mix.

RECEIVED  
STATE CORPORATION COMMISSION  
8-4-78  
AUG 04 1978

(If additional description is necessary, use BACK of this sheet)  
Name of Plugging Contractor, Kansas Clarke Corporation.

STATE OF Kansas COUNTY OF Barber, ss.  
Elma R. Morgenstern (employee of owner) or (owner or operator)  
of the above-described well, being first duly sworn on oath, says: That I have knowledge of  
the facts, statements, and matters herein contained and the log of the above-described well  
as filed and that the same are true and correct. So help me God.

(Signature) Elma R. Morgenstern  
Medicine Lodge, Kansas  
(Address)

SUBSCRIBED AND SWORN TO before me this 27th day of July, 19 78

Jessie Hamilton  
Notary Public.

My commission expires April 4, 1982




KS-077-20404-0000

Worksheet #1

160' FEL  $\frac{1}{2}$  710' FEL

SEC 9-315-52

Ames Co., KS

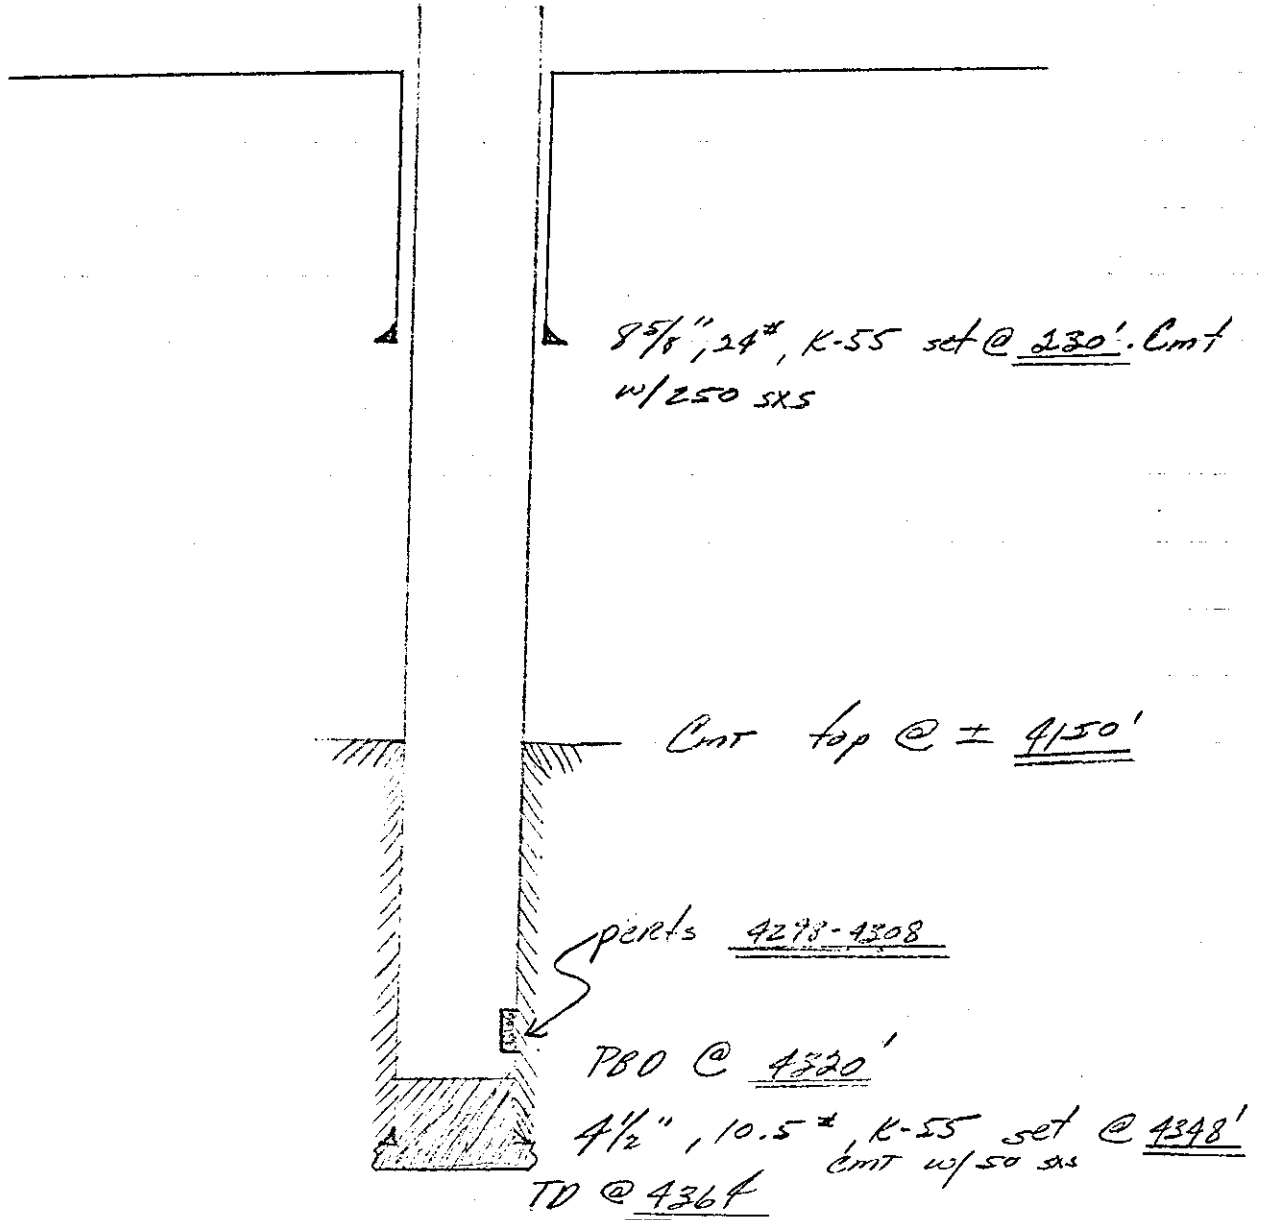

JUL 06 1973

7-6-78

