


STATE OF KANSAS
STATE CORPORATION COMMISSION
200 Colorado Derby Bldg.
Wichita, Kansas 67202

Form CP-4
Rev. 12-15-80

WELL PLUGGING RECORD

Give All Information Completely
Make Required Affidavit

COUNTY Rush SEC. 15 TWP. 17S RGE. 19W KXX
Location as in quarters or footage from lines:
SE NW NE

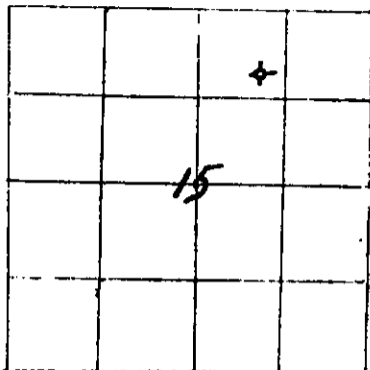

Lease Owner IREX Corp.
Lease Name Wilson Well No. 1
Office Address 1670 Broadway, Suite 3301, Denver, Colorado 80202
Character of Well (Completed as Oil, Gas or Dry Hole): Dry Hole
Date Well Completed July 3, 1983
Application for plugging filed July 3, 1983
Plugging commenced July 3, 1983
Plugging completed July 3, 1983
Reason for abandonment of well or producing formation Dry

Locate Well
correctly on above
Section Platt.

Was permission obtained from the Conservation Division or it's
Agent's before plugging was commenced? Yes

Name of Conservation Agent who supervised plugging of this well Bob Tarbutton

Producing formation Non-applicable Depth to top -- bottom -- T.D. 3980'

Show depth and thickness of all water, oil and gas formations.

OIL, GAS OR WATER RECORDS Non-applicable Casing Record

Formation	Content	From	To	Size	Put in	Pulled Out
				8 5/8"	347'	none

Describe in detail the manner in which the well was plugged, indicating where the mud fluid was placed and the method or methods used in introducing it into the hold. If cement or other plugs were used, state the character of same and depth placed, from 1426 feet to 40 feet for each plug set. Plug at 1426' w/50 sx; plug at 744' w/50 sx; plug at 403' w/40 sx; plug at 40' w/10 sx. Rat hole plugged w/15 sx. 155 sx. 60/40 poz 2% Gels, 3% CaCl. Plug at 7:45 P.M. 7/3/83.

RECEIVED
STATE CORPORATION COMMISSION
9-23-83

(If additional description is necessary, use BACK of this sheet.)
Name of Plugging Contractor Halliburton, Hays, Kansas

STATE OF Colorado COUNTY OF Denver, ss. William H. Bayliff,
Operations Manager, IREX Corp. (~~employee of owner~~ or ~~owner~~ or operator) of the
above-described well, being first duly sworn on oath, says: That I have knowledge of the
facts, statements, and matters herein contained and the log of the above-described well as
filed and that the same are true and correct. So help me God.

(Signature) William H. Bayliff
1670 Broadway, Suite 3301
(Address)
Denver, Colorado 80202

SUBSCRIBED AND SWORN TO before me this 15th day of September, 19 83

Mary J. Warren
Notary Public.

My Commission expires: June 9, 1985