

15-165-20986-0000


STATE OF KANSAS
STATE CORPORATION COMMISSION
200 Colorado Derby Bldg.
Wichita, Kansas 67202

Form CP-4
Rev. 12-15-80

WELL PLUGGING RECORD

Give All Information Completely
Make Required Affidavit

COUNTY Rush SEC. 1 TWP. 18 RGE. 16 W E/W
Location as in quarters or footage from lines:
50' W C SE/4

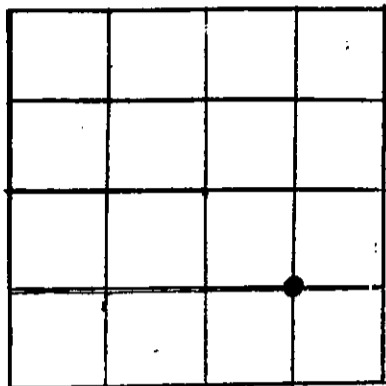

Locate Well
correctly on above
Section Platt.

Lease Owner Providence Energy Corp.
Lease Name LEBSACK Well No. 2
Office Address 3015 E. Skelly Drive, Tulsa, OK 74105
Character of Well (Completed as Oil, Gas or Dry Hole): dry hole
Date Well Completed 4/08/82
Application for plugging filed 4/08/82
Plugging commenced 4/08/82
Plugging completed 4/08/82
Reason for abandonment of well or producing formation dry hole

Was permission obtained from the Conservation Division or it's
Agent's before plugging was commenced? yes

Name of Conservation Agent who supervised plugging of this well S. Durrant
Producing formation _____ Depth to top _____ bottom T.D. 1980
Show depth and thickness of all water, oil and gas formations.

OIL, GAS OR WATER RECORDS

Casing Record

Formation	Content	From	To	Size	Put in	Pulled Out
		0	1035	8-5/8"	1035'	none

Describe in detail the manner in which the well was plugged, indicating where the mud
fluid was placed and the method or methods used in introducing it into the hold. If cement
or other plugs were used, state the character of same and depth placed, from _____ feet
to _____ feet for each plug set.

60 sks @ 1020'
40 sks @ 540'
10 sks @ 40'
10 sks in rathole
50/50 poz. 4% gel, 3% cc
plug down 1:30 PM, 4/8/82
by Sun

(If additional description is necessary, use BACK of this sheet)

Name of Plugging Contractor Allen Drilling Company

STATE OF KANSAS COUNTY OF BARTON, ss.
Roy Goans (employee of owner) or (~~owner or operator~~) of the
above-described well, being first duly sworn on oath, says: That I have knowledge of the
facts, statements, and matters herein contained and the log of the above-described well as
filed and that the same are true and correct. So help me God.

(Signature) Roy Goans
Box 1389, Gt. Bend, KS 67530
(Address)

SUBSCRIBED AND SWORN TO before me this 13th day of April, 19 82

My Commission expires: _____



Ruth Brack
Notary Public.

RECEIVED
STATE CORPORATION COMMISSION

7-20-83
JUL 20 1983

CONSERVATION DIVISION
Wichita, Kansas