


15-165-01850-0000

WELL PLUGGING RECORD

Also All Information Completely
Jobs Required Attached
Mail or Deflect Report to:
Conservation Division
State Corporation Commission
211 No. Broadway
Wichita, Kansas

NORTH

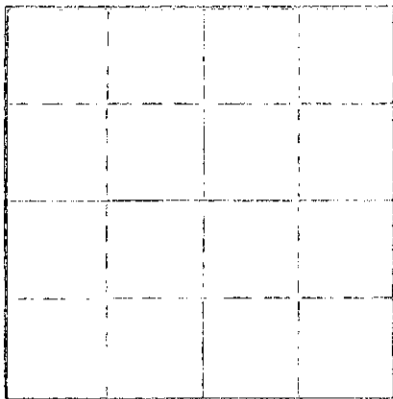

Locate well correctly on above
Section Plat

Rush County, Sec. 11 Twp. 18 Rge. (E) 16 (W)
Location as "NE/CNWSW" or footage from lines C/SE SE
Lease Owner: **Kansas Petroleum, Inc.**
Lease Name: **Hageigantz** Well No. **1**
Office Address: **820 Union Center, Wichita, Kansas**
Character of Well (completed as Oil, Gas or Dry Hole) **Dry Hole**
Date well completed **October 23** 19 **61**
Application for plugging filed **October 23** 19 **61**
Application for plugging approved **October 23** 19 **61**
Plugging commenced **October 23** 19 **61**
Plugging completed **12:10 P. M. October 23** 19 **61**
Reason for abandonment of well or producing formation **Dry Hole**

If a producing well is abandoned, date of last production _____ 19 ____
Was permission obtained from the Conservation Division or its agents before plugging was com-
menced? **Yes**

Name of Conservation Agent who supervised plugging of this well **Eldon Petty**
Producing formation _____ Depth to top _____ Bottom _____ Total Depth of Well _____ Feet
Show depth and thickness of all water, oil and gas formations.

OIL, GAS OR WATER RECORDS

CASING RECORD

FORMATION	CONTENT	FROM	TO	SIZE	PUT IN	PULLED OUT
	8-5/8"	0	1003'			

Describe in detail the manner in which the well was plugged, indicating where the mud fluid was placed and the method or methods used in introducing it into the hole. If cement or other plugs were used, state the character of same and depth placed, from _____ feet to _____ feet for each plug set.

Hole plugged as follows: Plugged with 35 sacks of cement, 1/4 sack of hulls at 300' mud to 40'; plugged with 10 sacks of cement and 1/4 sack of hulls. Job completed at 12:10 P. M. October 23, 1961.

RECEIVED
NOV 1 1961
11-1-61
CONSERVATION DIVISION
Wichita, Kansas

(If additional description is necessary, use BACK of this sheet)

Name of Plugging Contractor **Strata Drilling, Inc.**
Address **P. O. Box 355, Great Bend, Kansas**

STATE OF **KANSAS** COUNTY OF **BARTON**
Ralph Schuyler (employee of owner) or (owner or operator) of the above-described well, being first duly sworn on oath, says: That I have knowledge of the facts, statements, and matters herein contained and the log of the above-described well as filed and that the same are true and correct. So help me God.

(Signature) **Ralph Schuyler**
Ralph Schuyler
Box 355, Great Bend, Kansas
(Address)

Subscribed and Sworn to before me this **27th** day of **October**, 19**61**

My commission expires **December 14, 1961**
Elaine H. Taylor
Notary Public.

DRILLERS LOG

#1 Hagelqantz

CASING RECORD: 996' of new 8-5/8" surface casing
 COMPANY: Strata Drilling, Inc.
 CONTRACTOR: Kansas Petroleum, Inc.
 DESCRIPTION: C/SE SE Section 11-18-16W Rush County, Kansas
 TOTAL DEPTH: 3452'
 COMMENCED: October 16, 1961
 COMPLETED: October 23, 1961

D. & A

<u>FORMATION</u>	<u>FROM</u>	<u>TO</u>	<u>REMARKS</u>
Surface Clay & Shale	0	125	Ran 996' of new 8-5/8" surface casing; set and cemented at 1003' with 225 sacks posmix, 3% gel, 2% C. C. & 200 sacks of common cement, 2% gel and 2% C. C. Plug down at 5:00 P. M. October 16, 1961. Cement circ.
Shale	125	434	
Sand	434	600	
Shale & Shells	600	710	
Red Bed	710	770	
Red Bed & Anhydrite	770	1005	
Anhydrite	1005	1026	
Shale	1026	1700	
Shale & Lime	1700	2405	
Lime	2405	2420	
Shale & Lime	2420	3145	
Lime	3145	3452	

Total Depth 3452'

RECEIVED
 STATE CORPORATION COMMISSION

NOV 1 1961
 11-1-61
 CONSERVATION DIVISION
 Topeka, Kansas

D. & A.

Plugged at 300' with 35 sacks of cement, 1/4 sack of hulls and mud to 40'; plugged with 10 sacks of cement, 1/4 sack of hulls. Job completed at 12:10 P. M. October 23, 1961.

STATE OF KANSAS)
) ss.
 COUNTY OF BARTON)

I certify that this is a true and correct copy of the above log to the best of my knowledge.

STRATA DRILLING, INC.

Charles W. Steincamp
 Charles W. Steincamp, President

Subscribed and sworn to before me this 24th day of October, 1961.

Elaine H. Taylor
 Elaine H. Taylor, Notary Public

My Commission Expires:
 December 14, 1961