


WELL PLUGGING RECORD

Give All Information Completely
Make Required Affidavit
Mail or Deliver Report to:
Conservation Division
State Corporation Commission
212 No. Market
Wichita, Kansas

Rush County. Sec. 25 Twp. 18 Rge. 16 (E) (W) X
Location as "NE/CNW/SE/SW" or footage from lines SE NE NW

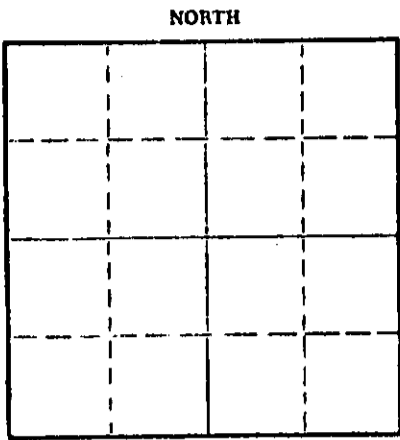

Locate well correctly on above
Section Plat

Lease Owner Carl Boxberger
Lease Name Moore Well No. 1
Office Address P. O. Box 174 Great Bend, Kansas
Character of Well (completed as Oil, Gas or Dry Hole) _____
Date well completed _____
Application for plugging filed 1-30-67
Application for plugging approved 1-31-67
Plugging commenced 2-1-67
Plugging completed 3-28-67
Reason for abandonment of well or producing formation _____

RECEIVED
APR 7 1967
4 7-67
CONSERVATION DIVISION
WICHITA, KANSAS

If a producing well is abandoned, date of last production _____ 19____
Was permission obtained from the Conservation Division or its agents before plugging was commenced? Yes

Name of Conservation Agent who supervised plugging of this well Leo F. Massey
Producing formation _____ Depth to top _____ Bottom _____ Total Depth of Well PB 3510 Feet
Show depth and thickness of all water, oil and gas formations.

OIL, GAS OR WATER RECORDS

CASING RECORD

FORMATION	CONTENT	FROM	TO	SIZE	PUT IN	PULLED OUT
				8 5/8	950	None
				4 1/2	None	745

Describe in detail the manner in which the well was plugged, indicating where the mud fluid was placed and the method or methods used in introducing it into the hole. If cement or other plugs were used, state the character of same and depth placed, from _____ feet to _____ feet for each plug set.

Rigged up unit. Ran bailer - top of fluid at 3112'. Ran Howco line to bottom 3568'.

Sanded back from 3568' to 3500'. Mixed and dumped 4 sacks on bridge at 3500'. Dug cellar.

Bled off pressure. Unpacked braden head. Rigged up jacks. Working pipe - had 9" tension at 20 joints. Shot pipe at 2920'. Working pipe.

Working pipe. Shot pipe at 2010'. Working pipe. Shot pipe at 1500'. Working pipe. Pulled pipe into. Set one plug at 950' with 3 sacks of cement. Mudded to 400'. Set 10' bridge with 7 sacks.

Loaded hole with 6 yards of Redi Mix cement from 330' to base of cellar.

(If additional description is necessary, use BACK of this sheet)

Name of Plugging Contractor Forbes Casing Pulling, Inc.
Address P. O. Box 221 Great Bend, Kansas

STATE OF Kansas COUNTY OF Barton, ss.
J. O. Forbes (employee of owner) or (owner or operator) of the above-described well, being first duly sworn on oath, says: That I have knowledge of the facts, statements, and matters herein contained and the log of the above-described well as filed and that the same are true and correct. So help me God.

(Signature) J. O. Forbes
P. O. Box 221 Great Bend, Kansas
(Address)

SUBSCRIBED AND SWORN TO before me this 6 day of April, 1967

My commission expires May 27, 1969

Notary Public.

15-165-00012-0000


WELL LOG BUREAU—KANSAS GEOLOGICAL SOCIETY
508 East Murdock, Wichita, Kansas

Company: P. E. THAYER ET AL
Farm: Moore No. 1

SEC. 25 T. 18 R. 16W
SE NE NW

Total Depth. 3543
Comm. 8-25-52 Comp. 9-5-52
Shot or Treated.
Contractor. Fleming & Woodman
Issued. 11-1-52

County Rush KANSAS

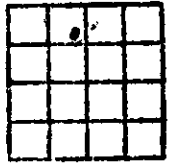

Elevation. 1928

Production. 4 BOPH

Figures Indicate Bottom of Formations.

top soil & clay	35
shale & sand	500
red rock	944
lime	975
shale & shells	1670
shale & lime	3240
lime	3510
Regan sand	3543
Total Depth	

Tops:	
Anhydrite	944
Heebner	3132
Brown Lime	3223
Kansas City	3233
Conglomerate	3472
Regan Sand	3510

Drilled plug & sand Fracked,
swabbed 4 BOPH

RECEIVED
STATE CORPORATION COMMISSION
JAN 31 1967
CONSERVATION DIVISION
Wichita, Kansas

$$\begin{array}{r} 3132 \\ 1928 \\ \hline 1204 \end{array}$$

$$\begin{array}{r} 3233 \\ 1928 \\ \hline 5 \end{array}$$

$$\begin{array}{r} 3510 \\ 1928 \\ \hline 1582 \end{array}$$

$$\begin{array}{r} 3543 \\ 1928 \\ \hline 1615 \end{array}$$