


STATE OF KANSAS
STATE CORPORATION COMMISSION

WELL PLUGGING RECORD

Get All Information Completely
Make Required Affidavit
Mail or Deliver Report to:
Conservation Division
State Corporation Commission
211 No. Broadway
Wichita, Kansas

Location as "NE/CNW/SE" or footage from lines Rush County, Sec. 25 Twp. 18 Rge. 16W (E) (W)
Lease Owner T. L. Nutt
Lease Name Hergert Well No. 1-B
Office Address Box 407, Ellinwood, Kansas
Character of Well (completed as Oil, Gas or Dry Hole) Oil
Date well completed May 13 19 58
Application for plugging filed May 12 19 58
Application for plugging approved _____ 19 _____
Plugging commenced May 14 19 58
Plugging completed May 21 19 58
Reason for abandonment of well or producing formation Not Commercial

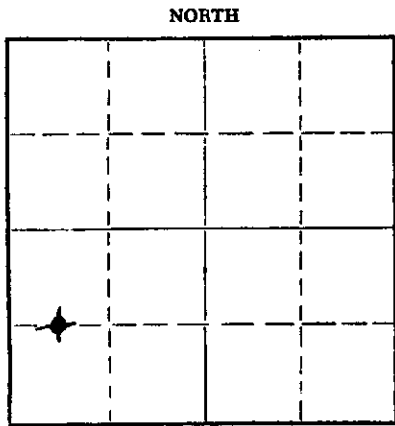

Locate well correctly on above
Section Plat

If a producing well is abandoned, date of last production April 1957
Was permission obtained from the Conservation Division or its agents before plugging was commenced? Yes

Name of Conservation Agent who supervised plugging of this well Elden Petty
Producing formation Reagan Sand Depth to top _____ Bottom 3554 Total Depth of Well 3554 Feet
Show depth and thickness of all water, oil and gas formations.

OIL, GAS OR WATER RECORDS

CASING RECORD

FORMATION	CONTENT	FROM	TO	SIZE	PUT IN	PULLED OUT
				15"	203'	None
				12"	076'	None
				7"	3520'	2847'

Describe in detail the manner in which the well was plugged, indicating where the mud fluid was placed and the method or methods used in introducing it into the hole. If cement or other plugs were used, state the character of same and depth placed, from _____ feet to _____ feet for each plug set.

3554' - 3520'	Tilled with sand
3520' - 3500'	Cement
3500' - 310'	Lead
310' - 295'	Rock
295' - 245'	30 sack cement
245' - 30'	mud
30' - 20'	rock
20' - 0'	15 sack cement

STATE CORPORATION COMMISSION
6-13-58
JUN 13 1958
CONSERVATION DIVISION
WICHITA, KANSAS

(If additional description is necessary, use BACK of this sheet)
Name of Plugging Contractor Glenn & Smith Piling Co
Address Ellinwood, Kansas

STATE OF Kansas, COUNTY OF Barton, ss.
T. L. Nutt (employee of owner) or (owner or operator) of the above-described well, being first duly sworn on oath, says: That I have knowledge of the facts, statements, and matters herein contained and the log of the above-described well as filed and that the same are true and correct. So help me God.

(Signature) T. L. Nutt
Box 407 Ellinwood, Kansas (Address)

SUBSCRIBED AND SWORN TO before me this 11th day of June, 19 58
Ulanda Michals
Notary Public.

My commission expires April 1, 1959

PLUGGING
FILE SEC 25 T. 18 R. 16W
BOOK PAGE 100 LINE 1


15-165-02155-0000

MORGAN AND FLYNN,
 Report No. 1-B

SEC. 25 T. 18 R. 16W.
 CNE SW

Total Depth. 3554
 Comn. 2-13-39 Comp. 4-13-39
 Shot or Treated.
 Contractor,
 Issued. 5-13-39

County. Rush

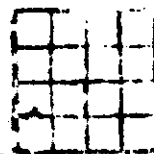

CASING.
 15" 203'
 12" 976'
 7" 3529'

Elevation.

Production Pot. 20CB.

Figures Indicate Bottom of Formations.

sand	60
shale and shells	203
shale and shells	395
sand	460
shale	565
sand	595
shale	660
sand	670
shale	715
sand and red shale	900
sand and shale	966
anhydrite	976
anhydrite	996
red rock	1075
shale and shells	1165
shale and shells	2035
shale and lime	2105
lime	2295
shale and lime	2365
broken lime	2530
broken lime	2640
lime	2715
shale	2750
shale and shells	2885
broken lime	3195
lime	3465
conglom. rate	3520
shale and lime	3531
sand and shale	3546
lime	3546
lime	3549
sand	3554
Total Depth.	

RECEIVED
 STATE GEOLOGICAL COMMISSION
 6-13-58
 JUN 13 1958
 CONSERVATION DIVISION
 Wichita, Kansas

PLUGGING
 FILE SEC. 25 T. 18 R. 16W
 BOOK PAGE 100 LINE 1