


STATE OF KANSAS  
STATE CORPORATION COMMISSION

Form CP-4

Give All Information Completely  
Make Required Affidavit  
Mail or Deliver Report to:  
Conservation Division  
State Corporation Commission  
212 No. Market  
Wichita, Kansas

## WELL PLUGGING RECORD

NORTH

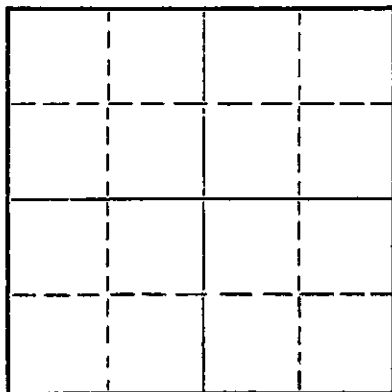

Locate well correctly on above  
Section Plot

Rush County. Sec. 34 Twp. 17S Rge. 19W ~~XE~~ (W)  
Location as "NE/CNW/SW" or footage from lines NE NE NW  
Lease Owner Glenn Rupe  
Lease Name Foos Well No. 1  
Office Address 222 Brown Bldg., Wichita, Kansas  
Character of Well (completed as Oil, Gas or Dry Hole) Dry Hole  
Date well completed 11-11-67 19  
Application for plugging filed 11-11-67 19  
Application for plugging approved 11-11-67 19  
Plugging commenced 11-11-67 19  
Plugging completed 11-11-67 19  
Reason for abandonment of well or producing formation Dry Hole

If a producing well is abandoned, date of last production 19  
Was permission obtained from the Conservation Division or its agents before plugging was commenced? yes

Name of Conservation Agent who supervised plugging of this well Leo Massey  
Producing formation \_\_\_\_\_ Depth to top \_\_\_\_\_ Bottom \_\_\_\_\_ Total Depth of Well 3941 Feet  
Show depth and thickness of all water, oil and gas formations.

## OIL, GAS OR WATER RECORDS

## CASING RECORD

FORMATION	CONTENT	FROM	TO	SIZE	PUT IN	PULLED OUT
				8 5/8"	254'	none

Describe in detail the manner in which the well was plugged, indicating where the mud fluid was placed and the method or methods used in introducing it into the hole. If cement or other plugs were used, state the character of same and depth placed, from \_\_\_\_\_ feet to \_\_\_\_\_ feet for each plug set.

Plug set @ 660' with 100 sacks Posmix  
Plug set @ 250' with 25 sacks Posmix  
Plug set @ 40' with 10 sks. Posmix

RECEIVED  
MAY 16 1967  
11-16-67  
CONSERVATION DIVISION  
WICHITA, KANSAS

(If additional description is necessary, use BACK of this sheet)

Name of Plugging Contractor Leben Drilling, Inc.  
Address Box 486, Great Bend, Kansas 67530

STATE OF KANSAS, COUNTY OF BARTON, ss.  
Leslie Kite

(employee of owner) or (owner or operator) of the above-described well, being first duly sworn on oath, says: That I have knowledge of the facts, statements, and matters herein contained and the log of the above-described well as filed and that the same are true and correct. So help me God.

(Signature)

Leslie Kite

Box 486, Great Bend, Kansas 67530

(Address)

SUBSCRIBED AND SWORN to before me this 15th day of November, 1967My commission expires April 1, 1971Ulanda Nichols

Notary Public.

## DRILLER'S LOG

COMPANY: Glenn Rupe  
 CONTRACTOR: LEBEN DRILLING, INC.  
 FARM: FOOS #1  
 LOCATION: NE NE NW SECTION 34-17S-19W  
 RUSH COUNTY, KANSAS  
 COMMENCED: 11-1-67  
 COMPLETED: 11-11-67

0	35	Yellow Clay
35	254	Shale, Shells
254	720	Shale, Redbed
720	950	Sand
950	1315	Redbed, Shale
1315	1345	Anhydrite
1345	1550	Shale, Shells
1550	1850	Shale
1850	3480	Lime, Shale
3480	3685	Lime
3685	3760	Lime, Chert
3760	3800	Lime, Shale
3800	3830	Lime
3830	3865	Lime, Chert
3865	3915	Lime
3915	3941	Lime, Chert
	<u>3941</u>	<u>RTD - D. &amp; A.</u>

RECEIVED  




8 5/8" 20# 8 rd. new surface casing set @ 254' cemented with 160 sacks Common, 2% cc

I, Leslie Kite, do hereby certify that the above and foregoing is a true and correct copy of the log of the Foos #1 Well, located NE NE NW of Section 34, Township 17 South, Range 19 West, Rush County, Kansas, as reflected by the records of Leben Drilling, Inc.

Leslie Kite

Leslie Kite

STATE OF KANSAS )  
 ) SS  
 COUNTY OF BARTON )

Subscribed and sworn to and before me, a Notary Public, in and for Barton County, Kansas, this 15th day of November, 1967.

Ulanda Nichols

Ulanda Nichols

My Commission Expires:  
 April 1, 1971