

15-1165-02061-0000

WELL PLUGGING RECORD

OR
FORMATION PLUGGING RECORD

Strike out upper line when reporting plugging of formations.

Give All Information Completely
Make Required Affidavit
Mail or Deliver Report to:
Conservation Division
State Corporation Commission
800 Bitting Building
Wichita, Kansas

Rush County, Sec. 9 Twp. 19 Rge. 16 (E) (W)

Location as "NE¼NW¼SW¼" or footage from lines. Center 332

Lease Owner. Northern Natural Gas Co

Lease Name. Schmidt Well No. 1

Office Address. Box 1510, Omaha, Nebraska

Character of Well (completed as Oil, Gas or Dry Hole) Gas well

Date well completed. July 3, 19 36

Application for plugging filed. June 22 19 46

Application for plugging approved. By: H.W.Kerr. June 22 19 46

Plugging commenced. June 24 19 46

Plugging completed. July 9 19 46

Reason for abandonment of well or producing formation. Dakota water broke thru production string.

If a producing well is abandoned, date of last production. June 6 19 46

Was permission obtained from the Conservation Division or its agents before plugging was commenced? Permission was obtained from Mr. H.W.Kerr

Name of Conservation Agent who supervised plugging of this well. Mr. H.W.Kerr, 6t Bend, Kansas.

Producing formation. Reagan Sand Depth to top. 3490 Bottom. 3498 Total Depth of Well. 3534 Feet

Show depth and thickness of all water, oil and gas formations.

OIL, GAS OR WATER RECORDS

CASING RECORD

Formation	Content	From	To	Size	Put In	Pulled Out
Sand	Water	410	625	20	94	94
Sandy Lime	Water	5105	5160	16 OD	405	None
Sand	Gas	3490	3498	13 OD	1007	None
				10	2357	2357
				8	3235	3235
				7	3473	None

Describe in detail the manner in which the well was plugged, indicating where the mud fluid was placed and the method or methods used in introducing it into the hole. If cement or other plugs were used, state the character of same and depth placed, from _____ feet to _____ feet for each plug set.

Inasmuch as, this well was flowing water thru the 7" casing showing that the casing was bad it was deemed inadvisable to try to salvage any of the casing in the hole. The 7" casing was cemented at the time of running with 40 sax of cement which filled up app 400 ft. The well had a casing packer set at 3317 ft on 2" tubing. The tubing was shot off at that point and the packer was drove down solid and a 4 ft lead wool plug set after which 10 sax of cement was dumped making a total of app 60 ft of plug in the hole from 3317 to 3257 which is well below the top of the cement around the 7" casing. A plug was pumped down the 7" casing and the hole found at 600 ft. We then started to pump cement in the 7" casing with the bradenheads on the 13" and 16" open. We pumped in 625 sax of cement without getting any returns. We let the well set several days while waiting on more cement. On opening the well up we found that the 7" was full of solid cement to about 50 ft of the top of the hole. However water still flowed from the connections on the 16" and 15" bradenheads. After getting more cement we started pumping cement this time thru the 15" brdenhead with the water flowing from the 16" bradenhead. After pumping app 475 sax of cement we got good heavy cement returns from the 16" bradenhead and shut it in. We then went ahead pumping cement and squeezing until we had put in about 90 more sax of cement, finishing up at 225# pressure. We then put the hose in the 7" and filled it to the top with cement. Thus we have the 7" casing full of cement down past 600 ft and the annulus between the 7" and 15" and the annulus between 15" and 16" full of cement. Beside the 10 sax of cement used in the bottom hole plug we pumped in a total of 1206 sax of cement.

(If additional description is necessary use BACK of this sheet)

Correspondence regarding this well should be addressed to. John M Hanley
Address. Box 1510, Omaha, Nebraska.

STATE OF Kansas, COUNTY OF Rush
J.W. Hanna (employee of owner) or (owner or operator) of the above-described well,


being first duly sworn on oath, says: That I have knowledge of the facts, statements, and matters herein contained and the log of the above-described well as filed and that the same are true and correct. So help me God.

(Signature) J.W. Hanna

(Address) _____

My commission expires July 9 - 1948 day of July, 1946

Notary Public.

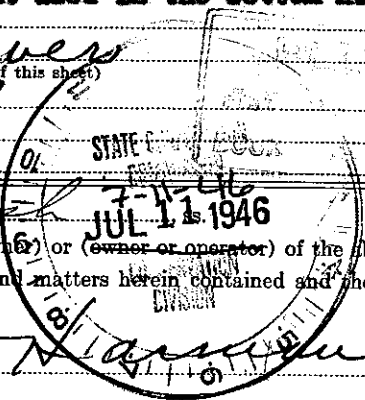

After cement had set 72 hours we went back and found that water was shut off in good shape but cement had settled about 75 ft between 13" and 7" pipe we then went back and pumped 28 sax of cement between those two strings filling them to the top.

J.W.Harman

P

INTERSTATE PRODUCTION NO. 1 SCHMIDT


SE 1/4 SECTION 9-18-16, Rush County,
Kansas

Started May 15, 1936
Completed July 3, 1936
Contractor Haskin Brothers
Altitude 1943
Production 5,600,00 cubic feet

Casing Record

20"	94
15 1/2"	405
12 1/2"	1007
10"	2357
8"	3255
7"	3473

<u>Formation</u>	<u>Depth</u>	<u>Formation</u>	<u>Depth</u>
Cellar	0 - 11	Lime	1400
Soil	18	Blue Shale	1425
Sand	50	Brown Shale	1445
Shale	85	Blue Salt	1500
Blue Shale	100	Salt	1645
Water Sand HFV	130	Salt	1705
Brown Shale	140	Lime & Dark Shale	1770
Blue Shale	145	Lime	1800
Red Shale	200	Red Shale	1805
Red Shale	205	Lime & Shale Breaks	1855
Blue Shale	210	Red Rock	1860
Blue Shale	215	Lime	1870
Blue Shale	220	Lime - Show Gas 1870-75	1895
Red Shale	230	Light Shale - 3 BW	1900
Blue Shale	310	Lime	1945
Blue Shale	325	Lime	1965
Lime	330	Red Rock	1985
Blue Shale	370	Lime	2000
Blue Shale	590	Lime	2120
Blue Shale	405	Red Shale	2125
Blue Shale	410	Lime	2135
Sand	460	Blue Shale	2140
Sand - Water Flowing	525	Lime-	2170
Red Rock	535	Blue Shale	2185
Red Shale	560	Lime	2190
Sand - More Water	625	Brown Shale	2195
Red Shale	705	Lime	2225
Red Shale	810	Lime	2240
Red Shale	890	Brown Shale	2250
Red Shale	995	Lime	2260
Lime -	1007	Lime & Shale	2315
Lime	1020	Red Rock	2325
Lime	1035	Lime	2330
Red Shale	1210	Red Rock	2355
Red Shale	1230	Lime	2364
Blue Shale & Shells	1275	Lime	2410
Brown Shale	1330	Red Rock & Blue Shale	2420
Blue Shale	1370	Lime	2425
Blue Shale	1380	Lime & Shale Breaks	2440

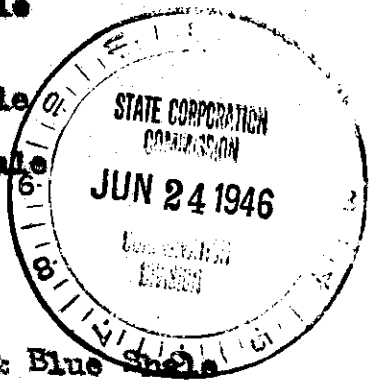

<u>Formation</u>	<u>Depth</u>	<u>Formation</u>	<u>Depth</u>
Lime - 1/4 BW	2480	Quartzite - rose	
Blue Shale & Shells	2500	colored quartz &	
Lime & Blue Shale Brks.	2570	black & white mica	3545
Lime & Shale Breaks	2635	Quartzite - rose	
Blue Shale	2660	colored quartz &	
Lime	2675	black & white mica	3559
Blue Shale	2695	Total Depth	3559
Lime & Shale	2810		
Brown Shale	2815		
Blue Shale & Shells	2870		
Lime	2885		
Blue Shale & Shells	2905		
Lime	2935		
Light Shale	2945		
Lime & Blue Shale	2995		
Sand Lime - 1 BW	3010		
Lime & Shale	3075		
Lime & Shale Breaks	3100		
Light Shale	3105		
Sandy Lime - 3 BW	3160		
Lime & Shale Breaks	3200		
Lime & Shale Breaks	3225		
Brown Shale	3235		
Blue Shale	3250		
Lime	3255		
Lime & Blue Shale Brks.	3260		
White Sandy Lime	3275		
Lime & Shale	3290		
Brown Shale	3295		
Dark Lime	3305		
Dark Lime-1 BW 3350-60	3345		
Sandy Lime	3400		
Lime	3455		
Red Shale	3460		
Lime	3465		
Shale Blue & Shells	3475		
Gas Sand	3474		
Sandy Lime	3483		
Lime & Blue Shale Brks.	3486		
Brown Shale	3488		
Blue Shale	3490		
Gas Sand	3493		
Gas Sand	3498		
Hard Lime	3506		
Brown Lime - Mica	3506		
Quartzite - Mica	3511		
Quartzite - Black &			
White Mica & rose			
colored quartz	3520		
Quartzite - Black &			
White Mica & more			
rose colored quartz	3524		
Quartzite - Mica & quartz			
	3534		

