


STATE OF KANSAS  
STATE CORPORATION COMMISSION

## WELL PLUGGING RECORD

Give All Information Completely  
Make Required Affidavit  
Mail or Deliver Report to  
Conservation Division  
State Corporation Comm.  
245 North Water  
Wichita, KS 67202

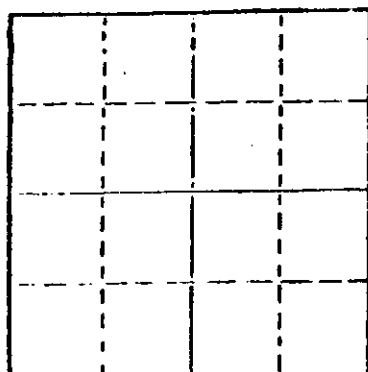

Locate well correctly on above  
Section Plat

Rush County. Sec. 22 Twp. 17S Rge. 19 ~~NE~~W  
Location as "NE/CNW $\frac{1}{4}$ SW $\frac{1}{4}$ " or footage from lines  
NE SW SW  
Lease Owner K.R.M. Petroleum Corp.  
Lease Name A.R. Wilson Well No. 1  
Office Address 817 17th St., Denver, Colo. 80202  
Character of Well (Completed as Oil, Gas or Dry Hole) dry hole

Date Well completed 9-21 19 79  
Application for plugging filed 9-21 19 79  
Application for plugging approved 9-21 19 79  
Plugging commenced 9-21 19 79  
Plugging completed 9-21 19 79  
Reason for abandonment of well or producing formation  
no commercial quantities of oil or gas encountered  
If a producing well is abandoned, date of last production  
-- 19

Was permission obtained from the Conservation Division or  
its agents before plugging was commenced? yes

Name of Conservation Agent who supervised plugging of this well Marion Schmidt  
Producing formation                      Depth to top                      Bottom                      Total Depth of Well 4060  
Show depth and thickness of all water, oil and gas formations.

## OIL, GAS OR WATER RECORDS

## CASING RECORD

FORMATION	CONTENT	FROM	TO	SIZE	PUT IN	PULLED OUT
<u>surface hole</u>	<u>shale</u>	<u>surf</u>	<u>326'</u>	<u>8-5/8</u>	<u>318'</u>	<u>none</u>

Describe in detail the manner in which the well was plugged, indicating where the mud fluid was placed and the method or methods used in introducing it into the hold. If cement or other plugs were used, state the character of same and depth placed, from                      feet to                      feet for each plug set.

Fluid to 655', plug, 60 sx  
Fluid to 320', plug, 30 sx  
Fluid to 40', plug, 10 sx  
Rat hole 5 sx

RECEIVED  
STATE CORPORATION COMMISSION

SEP 27 1979

9-27-79  
CONSERVATION DIVISION  
Wichita, Kansas

(If additional description is necessary, use BACK of this sheet)

Name of Plugging Contractor D N B DRILLING, INC.  
515 R. H. Garvey Building  
Wichita, Kansas 67202

STATE OF Kansas COUNTY OF Sedgwick, ss.  
Ella Priess (employee of owner) or (owner or operator)  
of the above-described well, being first duly sworn on oath, says: That I have knowledge of the facts, statements, and matters herein contained and the log of the above-described well as filed and that the same are true and correct. So help me God.

(Signature)

Ella Priess  
515 R.H. Garvey Bldg., Wichita, Ks. 67202  
(Address)

SUBSCRIBED AND SWORN TO before me this 21st day of September, 19 79

My commission expires April 30, 1983

Dorothy L. Schmidt  
Dorothy L. Schmidt Notary Public.

DOROTHY L. SCHMIDT  
STATE NOTARY PUBLIC  
Sedgwick County, Kansas  
My Appt. Exp. April 30, 1983

DRILLER'S LOG

K.R.M. PETROLEUM CORP.  
 No. 1 A.R. Wilson  
 NE SW SW  
 Sec. 22-17S-19W  
 Rush Co., Ks.

Commenced: 9-14-79  
 Completed: 9-21-79

Surface Casing: 318' of 8-5/8"  
 cmtd w/245 sx common, 3% cc

FORMATIONDEPTH

Surface	0 - 326
Shale	326 - 1715
Shale & Lime	1715 - 2515
Lime & Shale	2515 - 3090
Shale & Lime	3090 - 3280
Lime & Shale	3280 - 3630
Lime	3630 - 3920
Lime & Sandy Shale	3920 - 3995
Lime	3995 - 4060 RTD

I do hereby certify that the foregoing statements are true and correct to the best of my knowledge and belief.

D N B DRILLING, INC.

*Ella Priess*

Ella Priess

STATE OF KANSAS: ss:

Subscribed and sworn to before me this 21st day of September, 1979.

*Dorothy L. Schmidt*  
 Dorothy L. Schmidt, Notary Public

RECEIVED  
 STATE COMMISSION

SEP 27 1979  
 9-27-79

NOTARY PUBLIC DIVISION  
 Wichita, Kansas

DOROTHY L. SCHMIDT  
 STATE NOTARY PUBLIC  
 Sedgwick County, Kansas  
 My Appt. Exp. April 30, 1983