


STATE OF KANSAS
STATE CORPORATION COMMISSION

Form CP-4

WELL PLUGGING RECORD

Give All Information Completely
Make Required Affidavit
Mail or Deliver Report to:
Conservation Division
State Corporation Commission

P. O. Box 17027
Wichita, Kansas 67217
NORTH

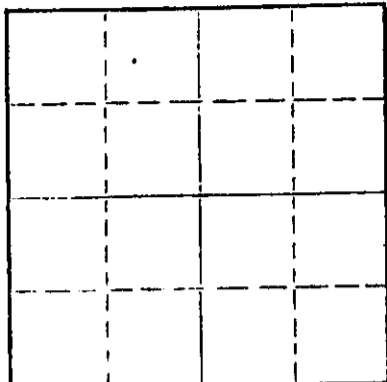

Locate well correctly on above
Section Plat

Rush County, Sec. 21 Twp. 17 Rge. 19 (E) W(W)

Location as "NE/CNWxSWx" or footage from lines SW SW NW
Lease Owner Cities Service Oil Co.
Lease Name LEGGE Well No. A-1
Office Address 710 Sutton Place Bldg., 209 E. William, Wichita, Ks. 67202
Character of Well (completed as Oil, Gas or Dry Hole) Dry Hole
Date well completed March 9 19 74
Application for plugging filed March 9 19 74
Application for plugging approved March 9 19 74
Plugging commenced March 9 19 74
Plugging completed March 10 19 74
Reason for abandonment of well or producing formation

If a producing well is abandoned, date of last production 19
Was permission obtained from the Conservation Division or its agents before plugging was commenced? YES

Name of Conservation Agent who supervised plugging of this well Leo Massey
Producing formation Depth to top Bottom Total Depth of Well 4060 Feet
Show depth and thickness of all water, oil and gas formations.

OIL, GAS OR WATER RECORDS

CASING RECORD

FORMATION	CONTENT	FROM	TO	SIZE	PUT IN	PULLED OUT

Describe in detail the manner in which the well was plugged, indicating where the mud fluid was placed and the method or methods used in introducing it into the hole. If cement or other plugs were used, state the character of same and depth placed, from feet to feet for each plug set.

Hole full of heavy mud.
Set bottom plug at 550' w/50 sacks cement thru drill pipe.
Middle plug set at 250' w/25 sacks cement thru drill pipe.
Top Plug set at 40' w/1/2 sack hulls and 10 sacks cement.

RECEIVED
STATE CORPORATION COMMISSION
MAR 14 1974
CONSERVATION DIVISION
Wichita, Kansas

(If additional description is necessary, use BACK of this sheet)

Name of Plugging Contractor Duke Drilling Co.
Address Box 823 - Great Bend, Ks. 67530

STATE OF Kansas, COUNTY OF Barton, ss.

Leonard Williamson (employee of owner) or (owner or operator) of the above-described well, being first duly sworn on oath, says: That I have knowledge of the facts, statements, and matters herein contained and the log of the above-described well as filed and that the same are true and correct. So help me God.

(Signature) Leonard Williamson

Box 823 - Great Bend, Kansas 67530
(Address)

SUBSCRIBED AND SWORN TO before me this 11th day of March 1974

Notary Public. *Alvord M. Wague*

My commission expires April 11, 1974

WELL LOG

DATE COMMENCED: February 21, 1974
 DATE COMPLETED: March 9, 1974

Cities Service Oil Co.
 LEDGE A-1
 SW SW NW
 Sec. 21-T173-R19W
 Rush County, Kansas

- 0 - 40' Surface Clay
- 40 - 110' Shale
- 110 - 140' Sand & Shale
- 140 - 150' Shale
- 150 - 320' Sand & Shale Streaks
- 320 - 705' Shale
- 705 - 820' Red Bed
- 820 - 1070' Sand
- 1070 - 1401' Red Bed
- 1401 - 1445' Anhydrite
- 1445 - 2090' Shale & Shells
- 2090 - 3240' Lime & Shale
- 3240 - 3550' Lime
- 3550 - 3573' Shale & Lime
- 3573 - 3599' Lime & Shale
- 3599 - 3875' Lime
- 3875 - 4018' Lime, Shale, Chert & Sand
- 4018 - 4060' Dolomite
- 4060' RTD

ELEVATION: 2215 K.B.

RECEIVED
 STATE CORPORATION COMMISSION
 MAR 14 1974
 CONSERVATION DIVISION
 Wichita, Kansas

FORMATION DATA

ANHYDRITE	1401
HESNER	3550
TORONTO	3573
KANSAS CITY	3599
BASE KANSAS CITY	3875
ARBUCKLE	4018

SURFACE PIPE: Set used 8-5/8" of
 24# casing at 320' with 250
 sacks 50/50 Pozmix, 2% Gel &
 3% c.c.

AFFIDAVIT

STATE OF KANSAS
 COUNTY OF BARTON) ss.

Leonard Williamson, of lawful age does swear and state that the facts and
 statements herein contained are true and correct to the best of his knowledge.

Leonard Williamson

Subscribed and sworn to before me this 12th day of March 1974.

Hersey M. Hague