

15-165-20383-00-00


STATE OF KANSAS
STATE CORPORATION COMMISSION

Form CP-4

Give All Information Completely
Make Required Affidavit
Mail or Deliver Report to:
Conservation Division
State Corporation Commission
212 No. Market
Wichita, Kansas 67202

WELL PLUGGING RECORD

Rush County, Sec. 29 Twp. 17S Rge. ~~XX~~ 18 (W)
Location as "NE/CNW/SW" or footage from lines SW SE NW
Lease Owner Pickrell Drilling Company
Lease Name Maneth "B" Well No. 1
Office Address 705 Fourth National Bank Bldg., Wichita, Kansas 67202
Character of Well (completed as Oil, Gas or Dry Hole) Dry Hole
Date well completed March 25 1971
Application for plugging filed March 25 1971
Application for plugging approved March 25 1971
Plugging commenced March 25 1971
Plugging completed March 25 1971
Reason for abandonment of well or producing formation Dry Hole

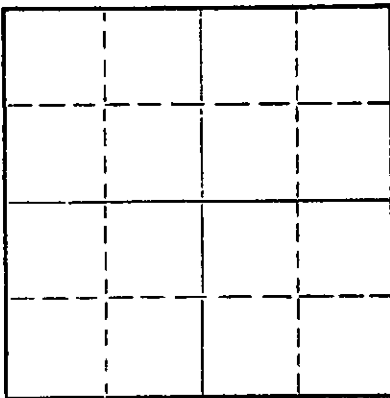

Locate well correctly on above
Section Plat

If a producing well is abandoned, date of last production 19
Was permission obtained from the Conservation Division or its agents before plugging was commenced? Yes

Name of Conservation Agent who supervised plugging of this well Leo F. Massey
Producing formation _____ Depth to top _____ Bottom _____ Total Depth of Well 3858 Feet
Show depth and thickness of all water, oil and gas formations.

OIL, GAS OR WATER RECORDS

CASING RECORD

FORMATION	CONTENT	FROM	TO	SIZE	PUT IN	PULLED OUT
				8-5/8"	256'	None

Describe in detail the manner in which the well was plugged, indicating where the mud fluid was placed and the method or methods used in introducing it into the hole. If cement or other plugs were used, state the character of same and depth placed, from _____ feet to _____ feet for each plug set.

Bottom Plug @ 465' w/70 sacks, Plug @ 240' w/20 sacks
Top Plug @ 40' w/10 Sacks.

RECEIVED
STATE CORPORATION COMMISSION
APR 1 1971
CONSERVATION DIVISION
Wichita, Kansas


04-01-1971

(If additional description is necessary, use BACK of this sheet)

Name of Plugging Contractor Pickrell Drilling Company
Address 705 Fourth National Bank Building, Wichita, Kansas 67202

STATE OF Kansas COUNTY OF Sedgwick ss.
C. W. Sebitts (employee of owner) or (owner or operator) of the above-described well, being first duly sworn on oath, says: That I have knowledge of the facts, statements, and matters herein contained and the log of the above-described well as filed and that the same are true and correct. So help me God.

(Signature) C. W. Sebitts
705 Fourth National Bank Bldg., Wichita, Kansas
(Address)

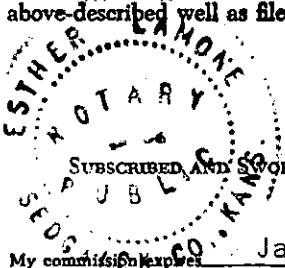

Subscribed and sworn to before me this 30th day of March, 1971
Esther Lamone
Notary Public.

ROTARY DRILLING LOG

15-165-20383-00-00

COMPANY: Pickrell Drilling Company
705 Fourth National Bank Building
Wichita, Kansas 67202

Rotary Drilling Commenced 3/17/71

Rotary Drilling Completed 3/25/71

LOCATION: Maneth "B" No. 1, SW SE NW Section 29-17S-18W
Rush County, Kansas

CONTRACTOR: **PICKRELL DRILLING COMPANY**
Wichita, Kansas

CASING RECORD: Run 12 Jts. 8-5/8" surface casing set at 256' KB. Cemented with 150 sacks cement. Completed 12:45 P.M. Circulated.

No oil string run. D & A, Plugged 12:45 P.M. March 25, 1971.

LOG

(Figures indicate bottom of formation — measurements from top of rotary bushing.)

100	Clay & Post Rock	
256	Shale & Shells, Cement	<u>C.F.S.</u>
660	Shale	3470
912	Sand	3492
1950	Shale	3547
2320	Shale & Lime	3671
2400	Lime & Shale	3810
2525	Shale & Lime	3813
2775	Lime	3825
3030	Shale & Lime	3842
3267	Lime & Shale	3858
3310	Shale & Lime	
3558	Lime & Shale	
3620	Shale & Lime	
3755	Lime & Shale	
3810	Shale & Lime -Sand?	
3813	Sand?	<u>Slope Tests</u>
3835	Sand - Shale	2000
3858	RTD	2500
		3000
		3500

RECEIVED
STATE CORPORATION COMMISSION
APR 1 1971
CONSERVATION DIVISION
Wichita, Kansas

04-01-1971

The undersigned, C. W. Sebitts, Attorney-in-Fact for PICKRELL DRILLING COMPANY, hereby certifies in behalf of said Company, that the above is a true and correct log of the formation encountered in drilling the above well as reflected by the Daily Drilling Reports.


PICKRELL DRILLING COMPANY

By C. W. Sebitts Attorney-in-Fact

STATE OF KANSAS }
COUNTY OF SEDGWICK } ss.:

On this 30th day of March, 1971, before me the undersigned, a Notary Public, in and for the County and State aforesaid, personally appeared C. W. Sebitts, to me known to be the identical person who subscribed the name of PICKRELL DRILLING COMPANY to the foregoing instrument as its Attorney-in-Fact and acknowledged to me that he executed the same as his free and voluntary act and deed, and as the free and voluntary act and deed of such company, for the uses and purposes therein set forth.

Given under my hand and seal of office the day and year last above written.

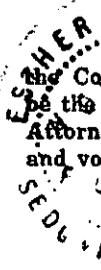

My commission expires: January 19, 1973

Esther Lamone
Esther Lamone Notary Public