

15-165 - 20466 - 00-00

STATE OF KANSAS
STATE CORPORATION COMMISSION

Form CP-4


Give All Information Completely
Make Required Affidavit
Mail or Deliver Report to:
Conservation Division
State Corporation Commission
212 No. Market
Wichita, Kansas 67202

WELL PLUGGING RECORD

Rush County, Sec. 21 Twp. 17 Rge. 20 (E) W (W)

Location as "NE/CNW/SW" or footage from lines SE NE SW
Lease Owner Jet Drilling Co., Inc.
Lease Name Yost Well No. 1
Office Address 514 One Twenty Bldg., Wichita, Kansas 67202
Character of Well (completed as Oil, Gas or Dry Hole) Dry hole
Date well completed 7-4 1973
Application for plugging filed 7-4 1973
Application for plugging approved 7-4 1973
Plugging commenced 7-4 1973
Plugging completed 7-4 1973
Reason for abandonment of well or producing formation Dry hole

NORTH

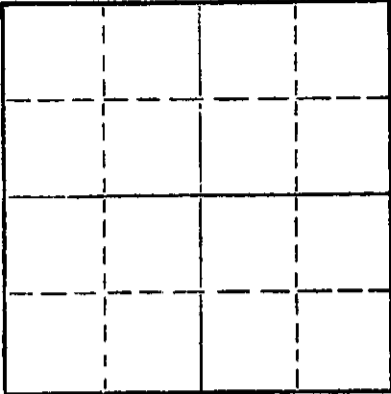

Locate well correctly on above Section Plat

If a producing well is abandoned, date of last production 19
Was permission obtained from the Conservation Division or its agents before plugging was commenced? Yes

Name of Conservation Agent who supervised plugging of this well Leo Massey
Producing formation _____ Depth to top _____ Bottom _____ Total Depth of Well 4,154 Feet
Show depth and thickness of all water, oil and gas formations.

OIL, GAS OR WATER RECORDS

CASING RECORD

FORMATION	CONTENT	FROM	TO	SIZE	PUT IN	PULLED OUT
				8 5/8"	471'	Cmtd. w/250 sax

Describe in detail the manner in which the well was plugged, indicating where the mud fluid was placed and the method or methods used in introducing it into the hole. If cement or other plugs were used, state the character of same and depth placed, from _____ feet to _____ feet for each plug set.

Fill hole w/heavy mud
Set bridge plug @500'
Spot 50 sax cement on plug thru 4 1/2" drill pipe
Fill hole w/heavy mud
Set bridge plug @40'
Dump 10 sax cement on plug to cellar

RECEIVED
STATE CORPORATION COMMISSION
JUL 12 1973
CONSERVATION DIVISION
Wichita, Kansas

07-12-1973

(If additional description is necessary, use BACK of this sheet)

Name of Plugging Contractor Shields Drilling Co., Inc.
Address Shields Bldg., Russell, Kansas 67665

STATE OF KANSAS, COUNTY OF RUSSELL, ss. R. L. Shields (employee of owner) or (owner or operator) contractor of the above-described

well, being first duly sworn on oath, says: That I have knowledge of the facts, statements, and matters herein contained and the log of the above-described well as filed and that the same are true and correct. So help me God.

(Signature) R. L. Shields, Jr.
Shields Bldg., Russell, Kansas
(Address)

SUBSCRIBED AND SWORN TO before me this 9th day of July, 1973

My commission expires May 26, 1975
Leah Phillips Notary Public.



15-165-20466-00-00


Shields

Russell, Kansas

WELL LOG

Operator: Jet Drilling Co., Inc.
 Well: Yost #1
 Commenced: June 24, 1973
 Completed: July 5, 1973
 Contractor: Shields Drilling Co., Inc.

Well Description: SE NE SW
 Sec. 21-17S-20W
 Rush Co., Kansas

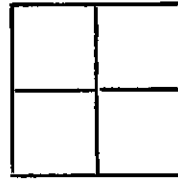

CASING RECORD		
Size	Run	Pulled
8 5/8"	471'	Cmtd. w/250 sax

Elevation: 2,176' RB
 Treatment:
 Production: D & A
 Tops:

..... Figures Indicate Bottom of Formations

Clay & shale	375'
Shale & shells	480'
Shale	830'
Sand	1,075'
Shale & redbed	1,409'
Anhydrite	1,444'
Shale & shells	2,140'
Shale & lime	3,550'
Lime	4,070'
Sand, lime & chert	4,147'
Lime	4,154' RTD

RECEIVED
 STATE CORPORATION COMMISSION

JUL 12 1973

CONSERVATION DIVISION
 Wichita, Kansas

07-12-1973

Notes