

15-165-00091-0000


WELL PLUGGING RECORD

Give All Information Completely  
Make Required Affidavit  
Mail or Deliver Report to:  
Conservation Division  
State Corporation Commission  
800 Bittling Building  
Wichita, Kansas

Rush County, Sec 13 Twp 17 Rge 19 (E) W (W)

Location as "NE/CNW/SW" or footage from lines SW SW SW  
Lease Owner Honaker-Davis Drlg. Co.  
Lease Name Greenway Well No. 1  
Office Address 2008 Lakin, Great Bend, Kansas  
Character of Well (completed as Oil, Gas or Dry Hole) Dry Hole  
Date well completed 4-9 19 56  
Application for plugging filed 4-9 19 56  
Application for plugging approved 4-9 19 56  
Plugging commenced 4-9 10:30 P.M. 19 56  
Plugging completed 4-9 11:30 P.M. 19 56  
Reason for abandonment of well or producing formation Dry Hole

NORTH

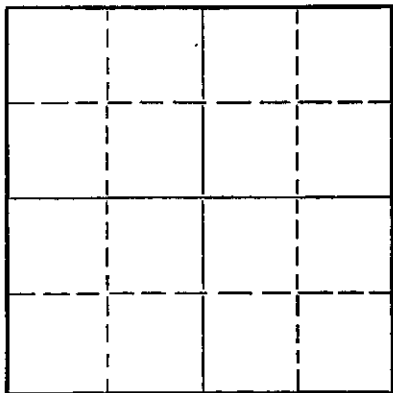

Locate well correctly on above  
Section Plat

If a producing well is abandoned, date of last production 19  
Was permission obtained from the Conservation Division or its agents before plugging was commenced? Yes Phone to Mr. Brundge, Hoisington, Kansas

Name of Conservation Agent who supervised plugging of this well Mr. Brundge  
Producing formation \_\_\_\_\_ Depth to top \_\_\_\_\_ Bottom \_\_\_\_\_ Total Depth of Well 3946 Feet  
Show depth and thickness of all water, oil and gas formations.

OIL, GAS OR WATER RECORDS

CASING RECORD

FORMATION	CONTENT	FROM	TO	SIZE	PUT IN	PULLED OUT
				8-5/8	254	None

Describe in detail the manner in which the well was plugged, indicating where the mud fluid was placed and the method or methods used in introducing it into the hole. If cement or other plugs were used, state the character of same and depth placed, from \_\_\_\_\_ feet to \_\_\_\_\_ feet for each plug set.

Pumped in Heavy Rotary Mud to Surface. Rolled 1/2 sack  
Hulls followed with HOWCO Plug, then squeezed with 90  
sacks cement.

(If additional description is necessary, use BACK of this sheet)

Name of Plugging Contractor Honaker-Davis Drlg. Co.  
Address 2008 Lakin, Great Bend, Kansas

STATE OF KANSAS, COUNTY OF BARTON, ss.  
R. I. Ellison (employee of owner) or (owner or operator) of the above-described well, being first duly sworn on oath, says: That I have knowledge of the facts, statements, and matters herein contained and the log of the above-described well as filed and that the same are true and correct. So help me God.

(Signature) R. I. Ellison  
Great Bend, Kansas  
(Address)

SUBSCRIBED AND SWORN TO before me this 10th day of April 1956

My commission expires 6-25-59

Kenneth G. Fischer Notary Public.  
STATE OF KANSAS  
3-59-20M

**PLUGGING**  
FILE SEC 13 T 17 R 19W  
BOOK 52 LINE 42

APR 11 1956  
4-11-56  
CONSERVATION DIVISION  
Wichita, Kansas

DRILLERS LOG

Greenway No. 1  
 Loc: SW SW SW  
 Sec: 13-17-19

Comm: 3-28-56  
 Comp: 4-9-56  
 Rotary Depth: 3946  
 Casing: 8-5/8" at 254'

Rush County, Kansas

Company: Honaker-Davis Drlg. Co., et al  
 Contractor: Honaker-Davis Drlg. Co.

0	70	Surface Soil, Post Rock & Clay
70	185	Shale & Shells
185	350	Shale
350	390	Sand
390	450	Shale, Red Bed & Sand Streaks
450	635	Shale, Red Bed & Sand
635	825	Dakota Sand
825	905	Red Bed
905	1225	Red Bed & Shale
1225	1330	Red Bed
1330	1365	Anhydrite
1365	1550	Shale & Shells
1550	1840	Shale, Shells & Salt and 3 sacks calcium chloride
1840	2100	Shale & Shells
2100	2150	Lime & Shale
2150	2450	Lime
2450	2555	Lime & Shale
2555	2710	Broken Lime & Shale
2710	2750	Shale
2750	2860	Lime & Shale
2860	2970	Lime & Shale
2970	3137	Lime & Shale
3137	3295	Shale & Lime
3295	3335	Lime & Shale
3335	3400	Lime
3400	3468	Lime & Shale
3468	3471	Shale (Heebner)
3471	3512	Lime & Shale
3512	3550	Lime (K. C.)
3550	3860	Lime
3860	3876	Lime & Sand
3876	3886	Sand & Conglomerate
3886	3903	Conglomerate
3903	3915	Arbuckle
3915	3920	Lime
3920	3946	Arbuckle
3946		Total Rotary Depth Dry & Abandoned

I certify that this is the true and correct copy  
 of the above log to the best of my knowledge.

*H. S. Forbes*

H. S. Forbes

Subscribed and sworn to before me this 10th day  
 of April, 1956.

*Kenneth G. Fischer*  
 Kenneth G. Fischer, Notary Public

4-11-56

My commission expires: 6-25-59

**PLUGGING**  
 LI SEC 13 T 17 R 19 W  
 OK PAGE 52 LINE 42