


15-165-20455-0000

STATE OF KANSAS
STATE CORPORATION COMMISSION

Form CP-4

WELL PLUGGING RECORD

Give All Information Completely
Make Required Affidavit
Mail or Deliver Report to:
Conservation Division
State Corporation Commission
P. O. Box 17027
Wichita, Kansas 67217
NORTH

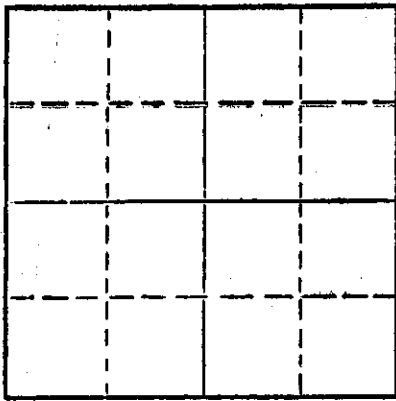

Locate well correctly on above
Section Plat

Rush County. Sec. 14 Twp. 17S Rge. 19W (E) (W) X
Location as "NE/CNW/SE" or footage from lines. SE NW SE
Lease Owner Childers Petroleum Corporation
Lease Name Adkinson "B" Well No. 2
Office Address 314 Petroleum Building, Wichita, Kansas 67202
Character of Well (completed as Oil, Gas or Dry Hole) D&A
Date well completed December 23 1972
Application for plugging filed December 23 1972
Application for plugging approved December 23 1972
Plugging commenced December 23 1972
Plugging completed December 23 1972
Reason for abandonment of well or producing formation D&A

If a producing well is abandoned, date of last production 19
Was permission obtained from the Conservation Division or its agents before plugging was commenced? Yes

Name of Conservation Agent who supervised plugging of this well Leo F. Massey
Producing formation _____ Depth to top _____ Bottom _____ Total Depth of Well 3930 Feet
Show depth and thickness of all water, oil and gas formations.

OIL, GAS OR WATER RECORDS

CASING RECORD

FORMATION	CONTENT	FROM	TO	SIZE	PUT IN	PULLED OUT
				8-5/8"	562'	-0-

Describe in detail the manner in which the well was plugged, indicating where the mud fluid was placed and the method or methods used in introducing it into the hole. If cement or other plugs were used, state the character of same and depth placed, from _____ feet to _____ feet for each plug set.

Set plug @ 500' w/25 sx cement, plug @ 40' w/10 sx cement, plugged rathole.

RECEIVED
STATE CORPORATION COMMISSION
JAN 2 1973
CONSERVATION DIVISION
Wichita, Kansas


(If additional description is necessary, use BACK of this sheet)

Name of Plugging Contractor Red Tiger Drilling Company
Address 1720 Wichita Plaza, Wichita, Kansas 67202

STATE OF Kansas, COUNTY OF Sedgwick, ss.
Gloria Fawcett (employee of owner) or (owner or operator) of the above-described well, being first duly sworn on oath, says: That I have knowledge of the facts, statements, and matters herein contained and the log of the above-described well as filed and that the same are true and correct. So help me God.

(Signature) Gloria Fawcett
1720 Wichita Plaza, Wichita, Kansas 67202
(Address)

SUBSCRIBED AND SWORN TO before me this 27th day of December, 1972

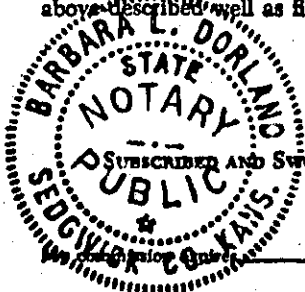

July 25, 1976.

Barbara L. Dorland
Notary Public.

DRILLERS LOG

No. 2 Adkinson "B"

CASING RECORD:	COMPANY:	Childers Petroleum Corporation	DESCRIPTION:
9-5/8" @ 562'	CONTRACTOR:	Red Tiger Drilling Company	SE NW SE
w/290 sx cement	COMMENCED:	December 13, 1972	14-17S-19W
TOTAL DEPTH: 3930'	COMPLETED:	December 23, 1972	Wash County, Kansas
			ELEVATION:

<u>FORMATION</u>	<u>FROM</u>	<u>TO</u>	<u>REMARKS</u>
Shale	0	1347	
Anhydrite	1347	1380	
Shale	1380	2030	
Shale & Lime	2030	2200	
Lime	2200	2850	
Shale & Lime	2850	3090	
Lime	3090	3930	

RECEIVED
STATE CORPORATION COMMISSION
JAN 2 1973
CONSERVATION DIVISION
Wichita, Kansas

I certify that this is a true and correct copy of the above log to the best of my knowledge.

RED TIGER DRILLING COMPANY

Gloria Fawcett
Gloria Fawcett

Subscribed and sworn to before me this 27th day of December, 1972.

Barbara L. Dorland
Notary Public

My Commission Expires:
July 25, 1976.

