

CARD MUST BE TYPED

State of Kansas

CARD MUST BE SIGNED

# NOTICE OF INTENTION TO DRILL

(see rules on reverse side)

Starting Date ..... April 20, 1987  
month day year

API Number 15- 165-21,379-00-00

OPERATOR: License # 9067  
Name DaMar Resources, Inc.  
Address P.O. Box 70  
City/State/Zip Hays, KS 67601  
Contact Person Daniel F. Schippers  
Phone (913) 625-0020

SE NW SE Sec. 21 Twp. 17 S, Rg. 20 X West  
1650 Ft. from South Line of Section  
1650 Ft. from East Line of Section

(Note: Locate well on Section Plat on reverse side)

CONTRACTOR: License # 4083  
Name Western Kansas Drilling, Inc.  
City/State Hays, KS 67601

Nearest lease or unit boundary line ..... 990 ..... feet  
County Rush

Well Drilled For: Well Class: Type Equipment:  
 Oil  SWD  Infield  Mud Rotary  
 Gas  Inj  Pool Ext.  Air Rotary  
 OWWO  Expl  Wildcat  Cable

Lease Name Rixon 'A' Well # 1  
Ground surface elevation ..... 2160 est. .... feet MSL

Domestic well within 330 feet:  yes  no  
Municipal well within one mile:  yes  no

If OWWO: old well info as follows:

Operator .....  
Well Name .....  
Comp Date ..... Old Total Depth .....

Depth to bottom of fresh water ..... 300 .....  
Depth to bottom of usable water ..... 475 .....

Surface pipe by Alternate: 1  2   
Surface pipe planned to be set ..... 500 .....

I certify that well will comply with K.S.A. 55-101, et seq., plus eventually plugging hole to KCC specifications.

Date 5-7-87 Signature of Operator or Agent *Daniel F. Schippers* Title President

For KCC Use:


Conductor Pipe Required ..... feet; Minimum Surface Pipe Required ..... 500 feet per Alt. 1 1/2  
This Authorization Expires 11-8-87 Approved By 5-8-87 *[Signature]*

Must be filed with the K.C.C. five (5) days prior to commencing well  
 This card void if drilling not started within six (6) months of date received by K.C.C.

**Important procedures to follow:**

**A Regular Section of Land**

1 Mile = 5,280 Ft.

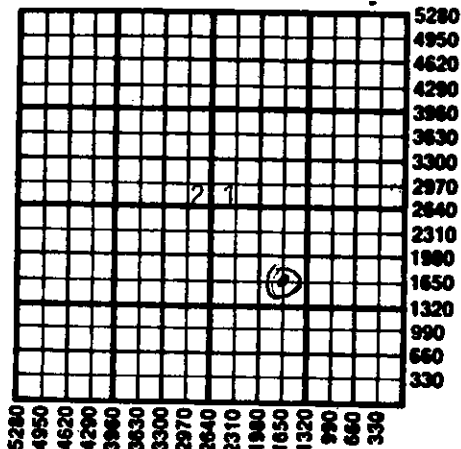

05-08-1987

1. Notify District office before setting surface casing.
2. Set surface casing by circulating cement to the top.
3. File completion forms ACO-1 with K.C.C. within 90 days of well completion, following instructions on ACO-1, side 1, and including copies of wireline logs.
4. Notify District office 48 hours prior to old well workover or re-entry.
5. Prior to filing Intent, prepare a proposed plugging plan in case well is ~~Discarded~~ then obtain approval of plan when calling district office prior to setting surface pipe.
6. Submit plugging report (CP-4) to K.C.C. after plugging is completed.
7. Obtain an approved injection docket number before disposing of salt water.
8. Notify K.C.C. within 10 days when injection commences or terminates.
9. If an alternate 2 completion, cement in the production pipe from below any usable water to surface within 120 days of spud date.

STATE CORPORATION COMMISSION

MAY 8 1987

CONSERVATION DIVISION  
 Wichita, Kansas

State Corporation Commission of Kansas  
 Conservation Division  
 200 Colorado Derby Building  
 Wichita, Kansas 67202