

CARD MUST BE TYPED

State of Kansas
NOTICE OF INTENTION TO DRILL
(see rules on reverse side)

COLLECTION
CARD MUST BE SIGNED
12-8-84

Starting Date: 10 10 84
month day year

A API Number 15- 165-21,259-00-00

OPERATOR: License # 9067
Name DaMar Resources, Inc.
Address P.O. Box 70
City/State/Zip Hays, KS 67601
Contact Person Daniel F. Schippers
Phone (913) 625-0020

S/2. N/2 NW/4 Sec 7 Twp 17 S, Rge 20 East
(location) West
4290 Ft North from Southeast Corner of Section
4010 Ft West from Southeast Corner of Section
(Note: Locate well on Section Plat on reverse side)

CONTRACTOR: License # 5381
Name Big Springs Drilling
City/State Wichita, KS 67208

Nearest lease or unit boundary line 990 feet.
County Rush
Lease Name Pabst Well # 1
Domestic well within 330 feet: yes no
Municipal well within one mile: yes no

Well Drilled For: Well Class: Type Equipment:
 Oil Swd Infield Mud Rotary
 Gas Inj Pool Ext. Air Rotary
 OWWO Expl Wildcat Cable

Depth to Bottom of fresh water 500 feet
Lowest usable water formation Dakota
Depth to Bottom of usable water 625 feet
Surface pipe by Alternate: 1 2
Surface pipe to be set 550 feet
Conductor pipe if any required none feet
Ground surface elevation 2147 feet MSL
This Authorization Expires 4-2-85
Approved By 10-2-84 *RC*

If OWWO: old well info as follows:
Operator
Well Name
Comp Date Old Total Depth
Projected Total Depth 4075 feet
Projected Formation at TD Cherokee
Expected Producing Formations Cherokee

I certify that we will comply with K.S.A. 55-101, et seq., plus eventually plugging holes to K.C.C. specifications.

KWS: 15-165-21,559

Date 10/1/84 Signature of Operator or Agent

[Signature]


Title President

m HC/KOHE 10/2/84

Must be filed with the K.C.C. five (5) days prior to commencing well
This card void if drilling not started within six (6) months of date received by K.C.C.

Important procedures to follow :

**A Regular Section of Land
1 Mile = 5,280 Ft.**

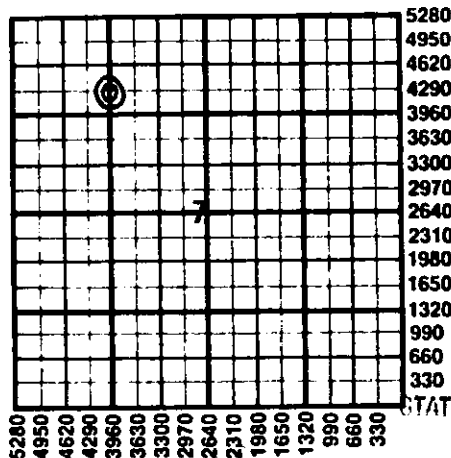

1. Notify District office before setting surface casing.
2. Set surface casing by circulating cement to the top.
3. File completion forms ACO-1 with K.C.C. within 90 days of well completion, following instructions on ACO-1, side 1, and including copies of wireline logs.
4. Notify District office 48 hours prior to old well workover or re-entry.
5. Prior to plugging, prepare a plugging plan, then obtain agreement from the appropriate district office for an approved plugging plan.
6. Submit plugging report (CP-4) to K.C.C. after plugging is completed.
7. Obtain an approved injection docket number before disposing of salt water.
8. Notify K.C.C. within 10 days when injection commences or terminates.
9. If an alternate 2 completion, cement in the production pipe from below and usable water to surface within 120 days of spud date.

RECEIVED

STATE CORPORATION COMMISSION

OCT 02 1984
10-02-1984
CONSERVATION DIVISION
Wichita, Kansas

State Corporation Commission of Kansas
Conservation Division
200 Colorado Derby Building
Wichita, Kansas 67202
(316) 263-3238