

CARD MUST BE TYPED

State of Kansas  
NOTICE OF INTENTION TO DRILL  
(see rules on reverse side)

CARD MUST BE SIGNED

Starting Date: 8 16 84  
month day year 4:22

API Number 15- 165-21,253-00-00

OPERATOR: License # 5140  
Name Frontier Oil Company  
Address 1720 Kansas State Bank Bldg.  
City/State/Zip Wichita, KS 67202  
Contact Person George A. Angle  
Phone 316-263-1201

W/2 W/2 SE Sec 12 Twp 17 S, Rge 18  
(location)  East  West

1320 Ft North from Southeast Corner of Section  
2310 Ft West from Southeast Corner of Section  
(Note: Locate well on Section Plat on reverse side)

CONTRACTOR: License # 5302  
Name Red Tiger Drilling Co.  
City/State Wichita, KS 67202

Nearest lease or unit boundary line 330 feet.  
County Rush  
Lease Name Stejskal Well# 1

Well Drilled For: Well Class: Type Equipment:  
 Oil  Swd  Infield  Mud Rotary  
 Gas  Inj  Pool Ext.  Air Rotary  
 OWWO  Expl  Wildcat  Cable

Domestic well within 330 feet:  yes  no  
Municipal well within one mile:  yes  no

If OWWO: old well info as follows:

Operator  
Well Name  
Comp Date Old Total Depth  
Projected Total Depth 3700 feet  
Projected Formation at TD Granite Wash  
Expected Producing Formations Winfield

Depth to Bottom of fresh water 100 feet  
Lowest usable water formation Dakota  
Depth to Bottom of usable water 550 feet  
Surface pipe by Alternate: 1  2   
Surface pipe to be set 1200 feet  
Conductor pipe if any required feet  
Ground surface elevation feet MSI.  
This Authorization Expires 2-14-85  
Approved By 8-14-84 [Signature]

I certify that we will comply with K.S.A. 55-101, et seq., plus eventual zoning hole to K.C.C. specification

Date 8/14/84 Signature of Operator or Agent

[Signature: George A. Angle]

Title OWNER

MHC/MOHE 8/14/84

RECEIVED  
STATE CORPORATION COMMISSION


AUG 14 1984

CONSERVATION DIVISION  
Wichita, Kansas

Must be filed with the K.C.C. five (5) days prior to commencing well  
This card void if drilling not started within six (6) months of date received by K.C.C.

08-14-1984

Regular Section of Land  
1 Mile = 5,280 Ft.

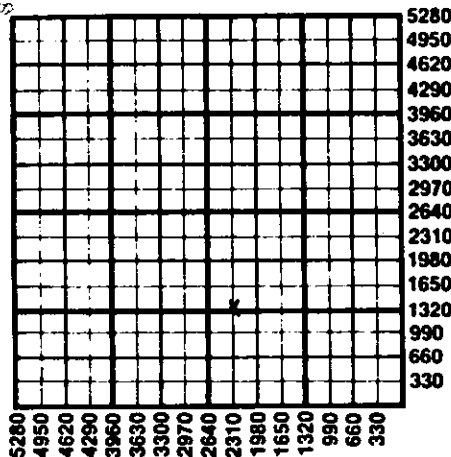

**Important procedures to follow:**

1. Notify District office before setting surface casing.
2. Set surface casing by circulating cement to the top.
3. File completion forms ACO-1 with K.C.C. within 90 days of well completion, following instructions on ACO-1, side 1, and including copies of wireline logs.
4. Notify District office 48 hours prior to old well workover or re-entry.
5. Prior to plugging, prepare a plugging plan, then obtain agreement from the appropriate district office for an approved plugging plan.
6. Submit plugging report (CP-4) to K.C.C. after plugging is completed.
7. Obtain an approved injection docket number before disposing of salt water.
8. Notify K.C.C. within 10 days when injection commences or terminates.
9. If an alternate 2 completion, cement in the production pipe from below any usable water to surface within 120 days of spud date.

State Corporation Commission of Kansas  
Conservation Division  
200 Colorado Derby Building  
Wichita, Kansas 67202  
(316) 263-3238