


STATE OF KANSAS
STATE CORPORATION COMMISSION

Give All Information Completely
Make Required Affidavit
Mail or Deliver Report to:
Conservation Division
State Corporation Commission
211 No. Broadway
Wichita, Kansas

WELL PLUGGING RECORD

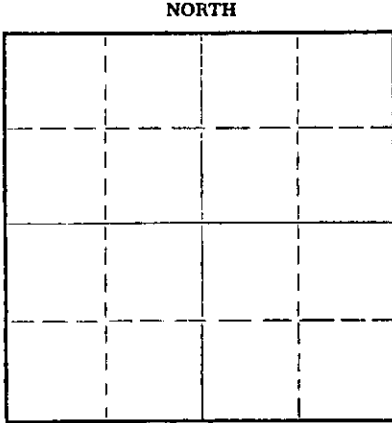

Locate well correctly on above
Section Plat

Sumner County. Sec. 8 Twp. 30 Rge. 1E (E) (W)

Location as "NE/CNWxSWx" or footage from lines SE SE SW
Lease Owner Shawver-Armour, Inc.
Lease Name Seydell Well No. 1-A
Office Address 817 Central Bldg., Wichita, Kansas
Character of Well (completed as Oil, Gas or Dry Hole) Dry hole
Date well completed 11-30 19 58
Application for plugging filed 11-30 19 58
Application for plugging approved 11-30 19 58
Plugging commenced 11-30 19 58
Plugging completed 11-30 19 58
Reason for abandonment of well or producing formation Dry hole

If a producing well is abandoned, date of last production _____ 19____
Was permission obtained from the Conservation Division or its agents before plugging was commenced? yes

Name of Conservation Agent who supervised plugging of this well Eugene Graham
Producing formation _____ Depth to top _____ Bottom _____ Total Depth of Well 3933 Feet
Show depth and thickness of all water, oil and gas formations.

OIL, GAS OR WATER RECORDS

CASING RECORD

FORMATION	CONTENT	FROM	TO	SIZE	PUT IN	PULLED OUT
Surface	water	0	268'	8 5/8"	268'	none

Describe in detail the manner in which the well was plugged, indicating where the mud fluid was placed and the method or methods used in introducing it into the hole. If cement or other plugs were used, state the character of same and depth placed, from _____ feet to _____ feet for each plug set.

Heavy mud to 240'
Plug & 1/2 sk. hulls
15 sacks cement
Mud to 40' Plug 1/2 sk. hulls
10 sack cement

RECEIVED
STATE CORPORATION COMMISSION
DEC 6 - 1958
CONSERVATION DIVISION
Wichita, Kansas

(If additional description is necessary, use BACK of this sheet)
Name of Plugging Contractor Shawver-Armour, Inc.
Address 817 Central Bldg., Wichita, Kansas

STATE OF KANSAS, COUNTY OF SEDGWICK, ss.
James M. Armour (employee of owner) or (owner or operator) of the above-described well, being first duly sworn on oath, says: That I have knowledge of the facts, statements, and matters herein contained and the log of the above-described well as filed and that the same are true and correct. So help me God.

(Signature) James M. Armour
JAMES M. ARMOUR
817 Central Bldg., Wichita
(Address)

SUBSCRIBED AND SWORN TO before me this 1st day of December, 19 58

My commission expires Dec. 29th, 1959

Marjorie Hall
MARJORIE HALL
Notary Public.

PLUGGING
FILE SEC 8 T. 30 R. 1E
BOOK PAGE 2 LINE 31

D R I L L E R ' S L O G

WELL: SEYDELL # 1-A

LOCATION: SE SE SW Sec. 8-30-1E
SUMNER COUNTY, KANSAS

CONTRACTORS: SHAWVER-ARMOUR, INC.

OWNERS: SHAWVER-ARMOUR, INC. et al ELEVATION: 1273 K.B.

SURFACE RECORD: 268' 8 5/8" W/225 sx. 2% cc

COMMENCED: 11-14-1958

COMPLETED: 11-30-1958

FORMATION

TOPS

Top Soil & Clay	40	Stalnaker	2471
Sand & Gravel	80	Base Stalanker	2601
Soft Blue Shale & Gravel	170	Kansas City	2808
Shale & Clay	216	Base Kansas City	3046
Shale & Anhydrite	268	Mississippi	3402
Anhydrite & Shale	450	Kinderhook	3805
Shale & Lime	550	Simpson	3863
Sandy Lime & Shale	675	Arbuckle	3930
Lime & Shale	865		
Shale, Lime & Shells	1185		
Shale & Lime Shells	1465		
Shale & Shells	1705		
Shale & Lime	1885		
Lime & Shale	2050		
Shale & Lime	2291		
Shale	2375		
Shale & Lime	2479		
Sand & Shale	2538		
Sandy Shale & Sand	2590		
Lime & Shale	2618		
Shale & Lime	2687		
Shale & Lime	2797		
Shale	2809		
Kansas City Lime	2858		
Lime	3042		
Shale & Lime	3399		
Shale	3401		
Mississippi	3420		
Mississippi Lime	3450		
Lime	3525		
Mississippi Lime	3552		
Lime	3619		
Mississippi Lime	3647		
Lime	3790		
Shale & Lime	3864 1/2		
Sand	3923		
Simpson Sand	3931		
Arbuckle	3933	RTD D & A	

RECEIVED
STATE OF KANSAS

DEC 6 - 1958

CONSERVATION DIVISION
Wichita, Kansas

STATE OF KANSAS)
SEDGWICK COUNTY) SS

I, James M. Armour, do hereby certify that the log on the above captioned well is a true and correct copy as shown on the daily drilling reports.

SHAWVER-ARMOUR, INC.

BY James M. Armour
JAMES M. ARMOUR

Subscribed and sworn to before me this
1st day of December, 1958
My commission expires Dec. 29th, 1959

Marjorie Hall
MARJORIE HALL, NOTARY PUBLIC

PLUGGING	
FILE SEC.	<u>8 T 30 R 1E</u>
BOOK PAGE	<u>2 LINE 26</u>