

STATE OF KANSAS
STATE CORPORATION COMMISSION

Form CP-4


Give All Information Completely
Make Required Affidavit
Mail or Deliver Report to:
Conservation Division
State Corporation Commission
211 No. Broadway
Wichita, Kansas

WELL PLUGGING RECORD

Sumner County, Sec. 22 Twp. 31 Rge. 1E (E) (W)

Location as "NE/CNW/SW" or footage from lines NE NE SE
Lease Owner DONALD C. SLAWSON
Lease Name Stewart Est. 'A' Well No. 1
Office Address 408 One Twenty Building - Wichita, Kansas
Character of Well (completed as Oil, Gas or Dry Hole) Dry hole
Date well completed 5-7-65
Application for plugging filed 5-7-65
Application for plugging approved 5-7-65
Plugging commenced 5-7-65
Plugging completed 5-7-65
Reason for abandonment of well or producing formation D & A

NORTH

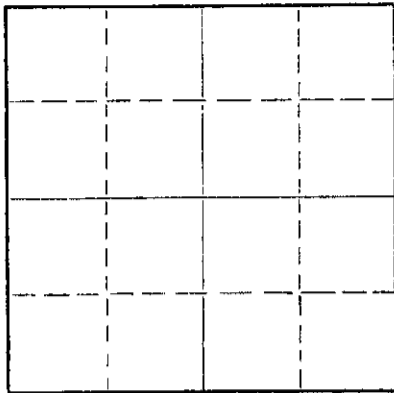

Locate well correctly on above
Section Plat

If a producing well is abandoned, date of last production 19
Was permission obtained from the Conservation Division or its agents before plugging was commenced? Yes

Name of Conservation Agent who supervised plugging of this well H. E. Hess - Winfield, Kansas
Producing formation _____ Depth to top _____ Bottom _____ Total Depth of Well 3025 Feet
Show depth and thickness of all water, oil and gas formations.

OIL, GAS OR WATER RECORDS

CASING RECORD

FORMATION	CONTENT	FROM	TO	SIZE	PUT IN	PULLED OUT

Describe in detail the manner in which the well was plugged, indicating where the mud fluid was placed and the method or methods used in introducing it into the hole. If cement or other plugs were used, state the character of same and depth placed, from _____ feet to _____ feet for each plug set.

Mud to 260', set plug, 1/4 sack of hulls, 20 sx cement.

Mud to 35', set plug, 1/4 sack of hulls, 8 sx cement.

20 sx cement in the rat hole

RECEIVED
STATE CORPORATION COMMISSION

MAY 17 1965

CONSERVATION DIVISION
Wichita, Kansas

(If additional description is necessary, use BACK of this sheet)

Name of Plugging Contractor Slawson Drilling Company, Inc.
Address 408 One Twenty Building - Wichita, Kansas

STATE OF KANSAS, COUNTY OF SEDGWICK, ss.
DONALD C. SLAWSON (employee of owner) or (owner or operator) of the above-described well, being first duly sworn on oath, says: That I have knowledge of the facts, statements, and matters herein contained and the log of the above-described well as filed and that the same are true and correct. So help me God.

(Signature) [Signature]
408 One Twenty Building - Wichita, Ks.
(Address)

SUBSCRIBED AND SWORN TO before me this 13th day of May, 19 65

My commission expires August 25, 1968 Ella Priess Notary Public.

2

22-31-1E

WELL LOG

Company: DONALD C. SLAWSON
 408 One Twenty Building
 Wichita, Kansas

Farm: Stewart Est. #A' #1
 NE NE SE, Section 22-31-1E
 Sumner County, Kansas

Total Depth: 3025' Elevation: 1259 K.B.

Commenced: May 1, 1965
 Completed: May 7, 1965

Contractor: Slawson Drilling Company, Inc.

Casing: 8 5/8" @ 243' with 225 sx cement

0-20	Surface clay
20-85	Shells & Shale
85-160	Shale & Shells
160-243	Lime & Shale
243-323	Lime
323-630	Lime & Shale
630-895	Shale & Shells
895-975	Lime & Shale
975-1845	Shale & Shells
1845-2320	Lime & Shale
2320-2423	Sandy shale
2423-2492	Shale
2492-2612	Sand - Stalnaker
2612-2861	Shale & Lime
2861-2932	K. C. Lime
2932-3025	Lime
3025	Total Depth


RECEIVED
 STATE CORPORATION COMMISSION
 MAY 17 1965
 CONSERVATION DIVISION
 Wichita, Kansas

STATE OF KANSAS)
) SS:
 COUNTY OF SEDGWICK)

I, Donald C. Slawson, of the Slawson Drilling Company, Inc., upon oath state that the above and foregoing is a true and correct copy of the log of the Stewart Est. 'A' #1 well.


 DONALD C. SLAWSON

Subscribed and sworn to before me this 13th day of May, 1965.

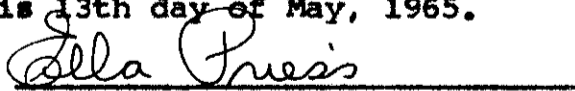
 Ella Priess, Notary Public

My Commission Expires:
 August 25, 1968