


15-077-20741-00-00

STATE OF KANSAS
STATE CORPORATION COMMISSION

Give All Information Completely
Make Required Affidavit
Mail or Deliver Report to
Conservation Division
State Corporation Commission
245 North Water
Wichita, KS 67202

FORM CP-4

WELL PLUGGING RECORD

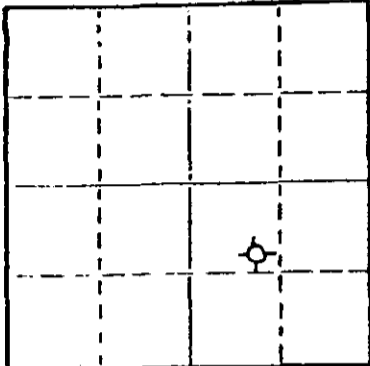

Locate well correctly on above
Section Plot

Harper County, Sec. 18 Twp. 31S Rge. (E) 5 (W)
Location as "NE/CNWKSW" or footage from lines SE NW SE
Lease Owner Robinowitz Oil Company
Lease Name Easterly Well No. #1
Office Address 6650 S. Lewis, Tulsa, OK 74136
Character of Well (completed as Oil, Gas or Dry Hole) Dry Hole
Date well completed 12-11 19 81
Application for plugging filed 12-12 19 81
Application for plugging approved 12-12 19 81
Plugging commenced 12-12 19 81
Plugging completed 12-12 19 81
Reason for abandonment of well or producing formation Dry

If a producing well is abandoned, date of last production 19
Was permission obtained from the Conservation Division or its agents before plugging was commenced? Yes

Name of Conservation Agent who supervised plugging of this well
Producing formation Depth to top Bottom Total Depth of Well 4702 Feet
Show depth and thickness of all water, oil and gas formations.

OIL, GAS OR WATER RECORDS

CASING RECORD

FORMATION	CONTENT	FROM	TO	SIZE	PUT IN	PULLED OUT
Kansas City	Water	3585		8 5/8	352	None
Simpson	Water	4678				

Describe in detail the manner in which the well was plugged, indicating where the mud fluid was placed and the method or methods used in introducing it into the hole. If cement or other plugs were used, state the character of same and depth placed, from feet to feet for each plug set.

Circulate hole w/heavy mud. Spot cement plugs as follows:
60 sx @ 620'
40 sx @ 314'
10 sx @ 40'
10 sx in rathole

(If additional description is necessary, use BACK of this sheet)

Name of Plugging Contractor Halliburton
Address

STATE OF Oklahoma COUNTY OF Tulsa SE.
Charles E. Son (employee of owner) or (owner or operator) of the above-described well, being first duly sworn on oath, says: That I have knowledge of the facts, statements, and matters herein contained and the log of the above-described well as filed and that the same are true and correct. So help me God.

(Signature) Charles E. Son
6650 S. Lewis, Tulsa, OK 74136
(Address)

SUBSCRIBED AND SWORN to before me this 21st day of January, 19 82

My commission expires March 13, 1985

Notary Public

RECEIVED
STATE CORPORATION COMMISSION

JAN 25 1982

COLLECTED BY STATE CORPORATION COMMISSION

01-25-1982