

WELL PLUGGING RECORD


Give All Information Completely
Make Required Affidavit
Mail or Deliver Report to:
Conservation Division
State Corporation Commission
211 No. Broadway
Wichita, Kansas

RECEIVED
SEP 21 1964
09-21-1964
CONSERVATION DIVISION
WICHITA, KANSAS

Harper County, Sec. 18 Twp. 31 Rge. 5 (E) W (W)

NORTH

Location as "NE/CNW/SW" or footage from lines C SW NE

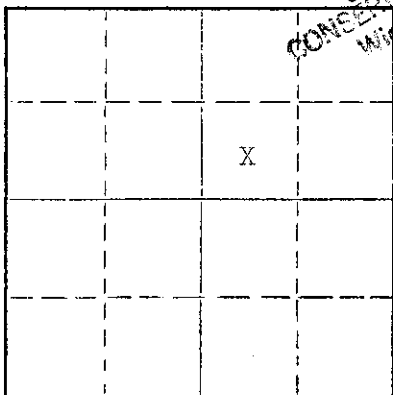

Locate well correctly on above Section Plat

Lease Owner Tenneco Oil Company
Lease Name H. G. Squires Well No. 1
Office Address Houston, Texas
Character of Well (completed as Oil, Gas or Dry Hole) Dryhole
Date well completed August 8, 19 64
Application for plugging filed 19
Application for plugging approved 19
Plugging commenced 9-3-64 19
Plugging completed 9-5-64 19
Reason for abandonment of well or producing formation Depleted.

If a producing well is abandoned, date of last production 19
Was permission obtained from the Conservation Division or its agents before plugging was commenced? yes

Name of Conservation Agent who supervised plugging of this well Archie Elving
Producing formation _____ Depth to top _____ Bottom _____ Total Depth of Well 4695 Feet
Show depth and thickness of all water, oil and gas formations.

OIL, GAS OR WATER RECORDS

CASING RECORD

FORMATION	CONTENT	FROM	TO	SIZE	PUT IN	PULLED OUT
				8-5/8"	252'	None
				5-1/2"	3819'	3215'

Describe in detail the manner in which the well was plugged, indicating where the mud fluid was placed and the method or methods used in introducing it into the hole. If cement or other plugs were used, state the character of same and depth placed, from _____ feet to _____ feet for each plug set.

Checked hole to plug back @ 3785', pushed plug to 3600', set rock bridge to 3595' and dumped 5 sacks of cement @ 3595' with dump bailer. Pulled 5 1/2" casing, bailed hole to 250', set rock bridge to 240' and dumped 25 sacks of cement @ 240'. Mudded hole to 40', set rock bridge to 30' and ran 10 sacks of cement to base of cellar.

PLUGGING COMPLETE.

(If additional description is necessary, use BACK of this sheet)

Name of Plugging Contractor Knight Casing Pulling Company
Address Chase, Kansas

STATE OF Kansas, COUNTY OF Rice, ss. Noel J. Knight

(employee of owner) or (~~CONSULTANT~~) of the above-described well, being first duly sworn on oath, says: That I have knowledge of the facts, statements, and matters herein contained and the log of the above-described well as filed and that the same are true and correct. So help me God.

(Signature) Noel J. Knight
Chase, Kansas
(Address)

SUBSCRIBED AND SWORN TO before me this 10th day of September, 19 64

My commission expires May 20, 1968 Milton J. Volin Notary Public.

GABBERT-JONES INC.
WICHITA, KANSAS
DRILLERS WELL LOG

RECORDED
STATE CORPORATION
SEP 8 1964
09-08-1964
CONSERVATION DEPARTMENT
Wichita, Kansas

15-077-00280-00-00

SQUIRES #1
C SW NE SECTION 18-31S-5W
HARPER COUNTY, KANSAS

COMMENCED: JUNE 30, 1964
COMPLETED: JULY 17, 1964

OPERATOR - TENNECO OIL COMPANY

DEPTH		FORMATION	REMARKS
FROM	To		
0	252	RED ROCK	RAN 12 JOINTS 8 5/8" CASING, SET @ 252' W/ 175 SACKS CEMENT
252	375	SHALE	
375	887	RED ROCK, BLUE CLAY	
887	925	ANHYDRITE	
925	1200	SHALE & SHELLS	
1200	2690	LIME & SHALE	
2690	2998	LIME	
2998	3580	LIME & SHALE	
3580	4240	LIME	
4240	4530	LIME - CHERT	
4530	4630	LIME & SHALE	
4630	4695	SAND	
4695	TD		RAN 119 JOINTS 5-1/2" CASING, SET @ 3819' W/ 100 SACKS CEMENT.

I, E. E. HALL, CERTIFY THIS IS A CORRECT COPY OF THE DRILLER'S LOG FOR THE WELL DRILLED IN C SW NE SECTION 18-31S-5W, HARPER COUNTY, KANSAS, TO THE BEST OF MY KNOWLEDGE AND BELIEF,

E. E. HALL

STATE OF KANSAS)
) SS
COUNTY OF SEDGWICK)

BEFORE ME, THE UNDERSIGNED, A NOTARY PUBLIC WITHIN AND FOR SAID COUNTY AND STATE ON THIS 21ST DAY OF JULY, 1964, PERSONALLY APPEARED E. E. HALL TO ME PERSONALLY KNOWN TO BE THE IDENTICAL PERSON WHO EXECUTED THE WITHIN AND FOREGOING INSTRUMENT AND ACKNOWLEDGED TO ME THAT HE EXECUTED THE SAME AS HIS FREE AND VOLUNTARY ACT AND DEED FOR THE USES AND PURPOSES THEREIN SET FORTH.

IN WITNESS WHEREOF, I HAVE HEREUNTO SET MY HAND AND OFFICIAL SEAL THE DAY AND YEAR LAST ABOVE WRITTEN.

VIRA A. MCKENZIE, NOTARY PUBLIC

MY COMMISSION EXPIRES OCTOBER 2, 1967