

15-077-20025-00-00 Form CP-4

STATE OF KANSAS  
STATE CORPORATION COMMISSION

Give All Information Completely  
Make Required Affidavit  
Mail or Deliver Report to:  
Conservation Division  
State Corporation Commission  
212 No. Market  
Wichita, Kansas

WELL PLUGGING RECORD

Harper County, Sec. 22 Twp. 31S Rge. 5 ~~W~~ W (W)

Location as "NE/CNW%SW%" or footage from lines C NE NE

Lease Owner Mack Oil Co.

Lease Name Hiebert Well No. 1

Office Address 812 Union Center Bldg., Wichita, Kansas 67202

Character of Well (completed as Oil, Gas or Dry Hole) Dry Hole

Date well completed June 1 1967

Application for plugging filed June 1 1967

Application for plugging approved June 1 1967


Plugging commenced June 2 1967

Plugging completed June 2 1967

Reason for abandonment of well or producing formation Dry

If a producing well is abandoned, date of last production 19

Was permission obtained from the Conservation Division or its agents before plugging was commenced? Yes

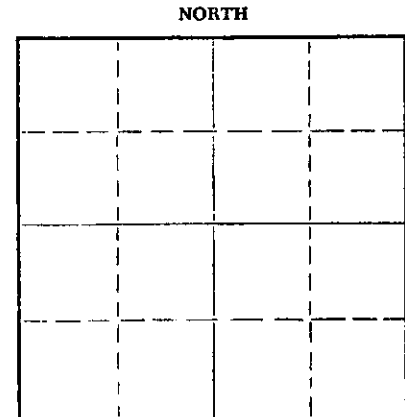

Locate well correctly on above Section Plat

Name of Conservation Agent who supervised plugging of this well Archie Elving, Pratt, Kansas

Producing formation None Depth to top Bottom Total Depth of Well 4665 Feet

Show depth and thickness of all water, oil and gas formations.

OIL, GAS OR WATER RECORDS

CASING RECORD

| FORMATION | CONTENT | FROM | TO | SIZE | PUT IN | PULLED OUT |
|-----------|---------|------|----|------|--------|------------|
|           |         |      |    |      |        |            |
|           |         |      |    |      |        |            |
Describe in detail the manner in which the well was plugged, indicating where the mud fluid was placed and the method or methods used in introducing it into the hole. If cement or other plugs were used, state the character of same and depth placed, from feet to feet for each plug set.

Plugged with 30 sax common cement @ 200'  
25 sax common cement @ 50'  
5 sax in rathole  
Plugging completed @ 10:30 a.m., June 2, 1967

RECEIVED  
STATE CORPORATION COMMISSION  
JUN 5 1967  
CONSERVATION DIVISION  
Wichita, Kansas  
06-05-1967

(If additional description is necessary, use BACK of this sheet)  
Name of Plugging Contractor Mack Oil Co.  
Address P. O. Box 400, Duncan, Oklahoma 73533

STATE OF KANSAS, COUNTY OF SEDGWICK, ss.

Robert L. Harris (employee of owner) or (owner or operator) of the above-described well, being first duly sworn on oath, says: That I have knowledge of the facts, statements, and matters herein contained and the log of the above-described well as filed and that the same are true and correct. So help me God.

(Signature) *Robert L. Harris*

812 Union Center Bldg., Wichita, Kans.  
(Address)

SUBSCRIBED AND SWORN TO before me this 2nd day of June, 1967

My commission expires September 21, 1968

*Elizabeth F. Nice*  
Elizabeth F. Nice Notary Public.

15-D77-20025-00-00

MACK OIL COMPANY  
Duncan, Oklahoma

DRILLERS WELL LOG

#1 Hiebert

C NE NE - Section 22-31S-5W  
Harper County, Kansas  
Elevation: 1323' Kelly Bushing  
Initial Production: Dry  
Contractor: Mack Oil Co.

Commenced R. D.: 5-23-67  
Completed R. D.: 5-31-67  
Rotary Total Depth: 4665'

| STRATA         | DEPTH        |
|----------------|--------------|
| Sand           | 0 - 50'      |
| Red Rock       | 50 - 227     |
| Shale          | 227 - 939    |
| Shale & Shells | 939 - 1390   |
| Lime           | 1390 - 1623  |
| Lime & Shale   | 1623 - 2337  |
| Shale          | 2337 - 2620  |
| Lime & Shale   | 2620 - 3123  |
| Shale          | 3123 - 3395  |
| Lime           | 3395 - 3837  |
| Lime & Shale   | 3837 - 3977  |
| Shale & Lime   | 3977 - 4134  |
| Lime           | 4134 - 4237  |
| Chat           | 4237 - 4324  |
| Chat & Lime    | 4324 - 4557  |
| Lime           | 4557 - 4665' |

RECEIVED  
STATE CORPORATION COMMISSION  
JUN 5 1967  
CONSERVATION DIVISION  
Wichita, Kansas

06-05-1967

I hereby certify that the above is a true and correct log of said well as reflected by the daily drilling reports.

MACK OIL CO.

By Robert L. Harris  
Robert L. Harris

Signed and sworn to in my presence this 2nd day of June, 1967, by Robert L. Harris, representative of Mack Oil Co.

Elizabeth F. Nice  
Elizabeth F. Nice, Notary Public

My Commission Expires September 21, 1968