

STATE OF KANSAS
STATE CORPORATION COMMISSION

Give All Information Completely
Make Required Affidavit
Mail or Deliver Report to:
Conservation Division
State Corporation Commission
211 No. Broadway
Wichita, Kansas

WELL PLUGGING RECORD

Harper County, Sec. 33 Twp. 31S Rge. 5W (E) (W)

Location as "NE/CNW/SWK" or footage from lines NW NE NW

Lease Owner Walters Drilling Co. & Oil Property Management, Inc.

Lease Name Loerger Well No. 1

Office Address 510 Orpheum Building, Wichita, Kansas 67202

Character of Well (completed as Oil, Gas or Dry Hole) Dry Hole

Date well completed 8-10-66 19

Application for plugging filed 8-10-66 19

Application for plugging approved 8-10-66 19


Plugging commenced 8-10-66 19

Plugging completed 8-10-66 19

Reason for abandonment of well or producing formation commercial quantities of oil not found

If a producing well is abandoned, date of last production 19

Was permission obtained from the Conservation Division or its agents before plugging was commenced? yes

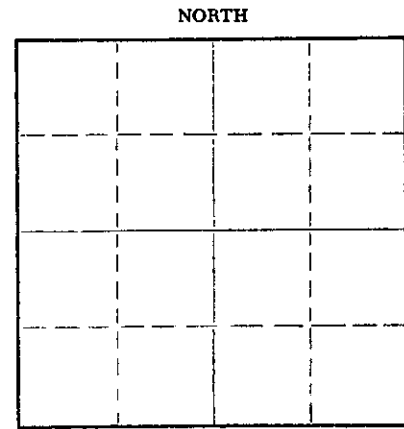

Locate well correctly on above Section Plat

Name of Conservation Agent who supervised plugging of this well Archie Elving, Pratt, Kansas

Producing formation Depth to top Bottom Total Depth of Well 4662 Feet

Show depth and thickness of all water, oil and gas formations.

OIL, GAS OR WATER RECORDS

CASING RECORD

FORMATION	CONTENT	FROM	TO	SIZE	PUT IN	PULLED OUT
				8 5/8"	210'	

Describe in detail the manner in which the well was plugged, indicating where the mud fluid was placed and the method or methods used in introducing it into the hole. If cement or other plugs were used, state the character of same and depth placed, from feet to feet for each plug set.

Bottom Plug @ 210' w/ 25 sacks cement.
Top Plug @ 40' w/ 10 sacks cement.
2 sacks cement in rathole

RECEIVED
STATE CORPORATION COMMISSION

AUG 12 1966

CONSERVATION DIVISION
WICHITA, KANSAS

08-12-1966

(If additional description is necessary, use BACK of this sheet)

Name of Plugging Contractor Walters Drilling Co.

Address 510 Orpheum Building, Wichita, Kansas 67202

STATE OF KANSAS, COUNTY OF SEDGWICK, ss.

Robert F. Walters (owner) of the above-described well, being first duly sworn on oath, says: That I have knowledge of the facts, statements, and matters herein contained and the log of the above-described well as filed and that the same are true and correct. So help me God.

(Signature) Robert F. Walters

510 Orpheum Building, Wichita, Kansas 67202 (Address)

Subscribed and Sworn to before me this 11th day of August, 1966

Juanita M. Green
Notary Public.

My commission expires October 4, 1967



15-077-30078-00-00

DRILLER'S LOG

COMPANY: Walters Drilling Co. & Oil Property Management, Inc.
510 Orpheum Building
Wichita, Kansas 67202

WELL NAME: Ioerger #1
NW NE NW Sec. 33-31S-5W
Harper County, Kansas

CONTRACTOR: Walters Drilling Co.
510 Orpheum Building
Wichita, Kansas 67202

ROTARY DRILLING COMMENCED: July 9, 1966
ROTARY DRILLING COMPLETED: August 9, 1966

ELEVATION: 1332 KB

CASING RECORD: 8 5/8" set @ 210' w/ 150 sacks cement

LOG

0 - 213	Surface Clay and Shale
213 - 800	Shale
800 - 1130	Shale and Lime Streaks
1130 - 2057	Lime and Shale
2057 - 2205	Shale
2205 - 2480	Shale and Lime Streaks
2480 - 2625	Shale and Lime
2625 - 2785	Shale
2785 - 2912	Shale and Sand Streaks
2912 - 2995	Shale and Lime
2995 - 3370	Shale
3370 - 3638	Shale and Lime
3638 - 3900	Lime
3900 - 3985	Lime and Shale
3985 - 4070	Lime
4070 - 4219	Lime and Shale
4219 - 4251	Lime and Chert
4251 - 4345	Lime
4345 - 4395	Lime and Chert
4395 - 4520	Lime
4520 - 4557	Lime and Shale
4557 - 4640	Shale and Lime
4640 - 4657	Shale and Sand
4657 - 4662	Sand
<u>4662</u>	<u>Rotary Total Depth - D & A</u>

RECEIVED
STATE CORPORATION COMMISSION

AUG 12 1966

CONSERVATION DIVISION
Wichita, Kansas


08-12-1966

The undersigned, Robert F. Walters, hereby certifies, in behalf of said company that the above log is a true and correct log of the formations encountered in drilling the above well as reflected by the Daily Drilling Reports.

WALTERS DRILLING CO.

BY Robert F. Walters
ROBERT F. WALTERS, Partner

Subscribed and sworn to before me
this 11th day of August, 1966.

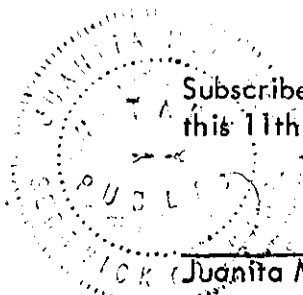

Juanita M. Green, Notary Public
My Commission Expires: October 4, 1967