

15-077-20129-00-00

STATE OF KANSAS
STATE CORPORATION COMMISSION


Form CP-4

Give All Information Completely
Make Required Affidavit
Mail or Deliver Report to:
Conservation Division
State Corporation Commission
212 No. Market
Wichita, Kansas 67202

WELL PLUGGING RECORD

HARPER County, Sec. 33 Twp. 31S Rge. (E) 5(W)

Location as "NE/CNWxSWx" or footage from lines 150 E of SE SE
Lease Owner KEENER OIL CO.
Lease Name SHORT Well No. 1
Office Address 406 Natl Bk of Tulsa Bldg. Tulsa, Oklahoma
Character of Well (completed as Oil, Gas or Dry Hole) Dry Hole
Date well completed 8/24 19 71
Application for plugging filed 8/24 19 71
Application for plugging approved 8/24 19 71
Plugging commenced 8/24 19 71
Plugging completed 8/24 19 71
Reason for abandonment of well or producing formation Dry

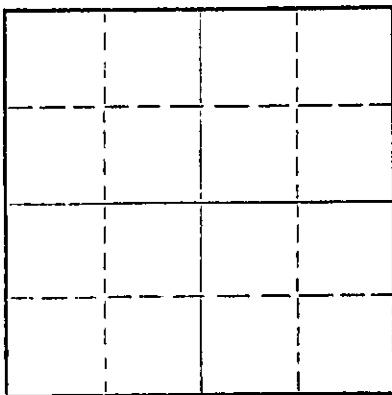

Locate well correctly on above
Section Plat

If a producing well is abandoned, date of last production 19
Was permission obtained from the Conservation Division or its agents before plugging was commenced? yes

Name of Conservation Agent who supervised plugging of this well Russell Biberstein
Producing formation Depth to top Bottom Total Depth of Well 4700 Feet
Show depth and thickness of all water, oil and gas formations.

OIL, GAS OR WATER RECORDS

CASING RECORD

FORMATION	CONTENT	FROM	TO	SIZE	PUT IN	PULLED OUT
Top soil		0	231	8 5/8	231	0

Describe in detail the manner in which the well was plugged, indicating where the mud fluid was placed and the method or methods used in introducing it into the hole. If cement or other plugs were used, state the character of same and depth placed, from feet to feet for each plug set.

Fill w/heavy mud to 200' set 1st plug w/35 sx cement
Fill w/heavy mud to 40' set 2nd plug w/10 sx cement
Bridge rathole w/2 sax cement.

RECEIVED
STATE CORPORATION COMMISSION
SEP 2 1971
CONSERVATION DIVISION
Wichita, Kansas

09-02-1971

(If additional description is necessary, use BACK of this sheet)

Name of Plugging Contractor GABBERT-JONES, INC.
Address 830 Sutton Place, Wichita, Kansas

STATE OF KANSAS, COUNTY OF SEDGWICK, ss.

Gabbert Jones (employee of owner) or (owner) of the above-described well, being first duly sworn on oath, says: That I have knowledge of the facts, statements, and matters herein contained and the log of the above described well as filed and that the same are true and correct. So help me God.


(Signature) Jack W. Gabbert, President
GABBERT JONES, INC., 830 Sutton Place, Wichita, Ks.
(Address)

Subscribed and sworn to before me this 1st day of September, 19 71

My commission expires Nov. 29, 1971

Marjorie Hall

Notary Public.

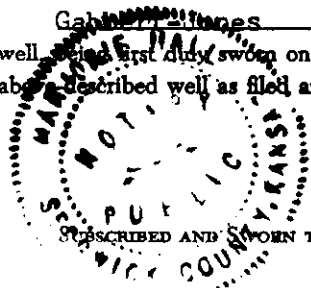

15-077-20129-0000

GABBERT-JONES, INC.
WICHITA, KANSAS
DRILLERS' WELL LOG


SHORT #1
C SE SE, SEC. 33-31S-5W
Harper County, Kansas

Commenced: August 13, 1971
Completed: August 24, 1971

OPERATOR: KEENER OIL CO.

DEPTH		FORMATION	REMARKS
From	To		
0	35	Sand	Ran 11 joints of used 8 5/8" casing
35	236	Redbed	Set @ 231' cement w/200 lbs common
236	400	Redbed and Shale	2 1/2 Gal-3% C.C.
400	876	Shale and Shells	P.D. @ 12:15 AM 8/14/1971
876		Anhydrite	Job by Halliburton
876	3580	Shale and Lime	
3580	4537	Lime	
4537	4658	Shale	
4658	4700	Sand	
4700	TD		Dry and Abandoned


I, James S. Sutton II, certify this is a correct copy of the Drillers' Log for the well drilled in the C SE SE, Section 33-31S-5W, Harper County, Kansas to the best of my knowledge and belief.

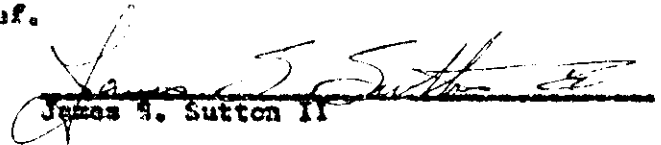
James S. Sutton II

STATE OF KANSAS)
) SS
COUNTY OF SEDGWICK)

Before me, the undersigned, a Notary Public within and for said County and State, on this 30th day of August, 1971, personally appeared James S. Sutton II to me personally known to be the identical person who executed the within and foregoing instrument and acknowledged to me that he executed the same as his free and voluntary act and deed for the uses and purposes therein set forth.

IN WITNESS WHEREOF, I have hereunto set my hand and official seal the day and year last above written.

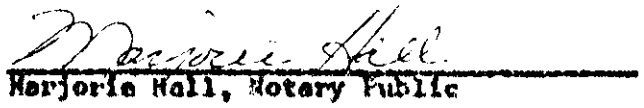
Marjorie Hall, Notary Public

My commission expires
Nov. 29, 1971

RECEIVED
STATE CORPORATION COMMISSION
SEP 2 1971
CONSERVATION DIVISION
Wichita, Kansas
09-02-1971