


Give All Information Completely
Make Required Affidavit
Mail or Deliver Report to:
Conservation Division
State Corporation Commission
212 North Market, Insurance Bldg.
Wichita, Kansas

15-077-10018-00-00
WELL PLUGGING RECORD

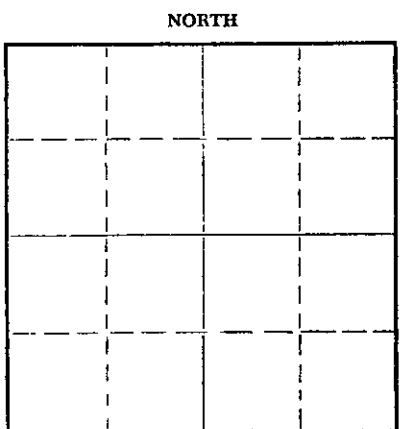

Harper County, Sec. 33 Twp. 31S Rge. (E) 5 (W)
Location as "NE/CNW/SW" or footage from lines NE NW NW
Lease Owner Natural Gas and Oil Company
Lease Name Loerger Well No. 2
Office Address P. O. Box 105 - Great Bend, Kansas
Character of Well (completed as Oil, Gas or Dry Hole) Oil
Date well completed 5-23 19 58
Application for plugging filed 9-2- 19 59
Application for plugging approved 9-3- Verbal 19 59
Plugging commenced 9-3- 19 59
Plugging completed 9-3- 19 59
Reason for abandonment of well or producing formation Depleted

If a producing well is abandoned, date of last production 6-30-59 19
Was permission obtained from the Conservation Division or its agents before plugging was commenced? Yes

Name of Conservation Agent who supervised plugging of this well Fred Hampel - Pretty Prairie, Kansas.
Producing formation Simpson Depth to top 4653 Bottom 4696 Total Depth of Well 4696 Feet
Show depth and thickness of all water, oil and gas formations.

OIL, GAS OR WATER RECORDS

CASING RECORD

FORMATION	CONTENT	FROM	TO	SIZE	PUT IN	PULLED OUT
				10-3/4"	317	-0-
				5-1/2"	4695	3978

Describe in detail the manner in which the well was plugged, indicating where the mud fluid was placed and the method or methods used in introducing it into the hole. If cement or other plugs were used, state the character of same and depth placed, from _____ feet to _____ feet for each plug set.

Sand from PWD 4681 to 4630'
5 sacks cement
Mud to 285'
Rock bridge to 275'
3 sacks cement to 230'
Steel plate on top of surface casing at ground level.
Job completed 3 pm 9-3-59

RECEIVED
STATE CORPORATION COMMISSION
SEP 9 1959
CONSERVATION DIVISION
Wichita, Kansas

09-09-1959

(If additional description is necessary, use BACK of this sheet)
Name of Plugging Contractor Noel Knight Casing Pulling Company
Address Chase, Kansas

STATE OF KANSAS COUNTY OF BARTON, ss.
J. B. Steele, Jr. (employee of owner) or ~~owner~~ of the above-described well, being first duly sworn on oath, says: That I have knowledge of the facts, statements, and matters herein contained and the log of the above-described well as filed and that the same are true and correct. So help me God.

(Signature) J. B. Steele, Jr.
P. O. Box 105 - Great Bend, Kansas
(Address)

SUBSCRIBED AND SWORN TO before me this 8th day of September, 19 59

Richard R. Beach
Notary Public.

My commission expires July 27, 1963

PLUGGING

File Sec. 33 T 31 R 5W
Book Page 1 Line 42

15-077-10018-00-00

W E L L L O G
Ioerger # 2
NE NW NW 33-31S-5W
Harper County, Kansas

0 - 70	Surface clay	Elevation	1339' DF
70 - 110	Shale		
110 - 317	Red Bed and shale		
317 - 772	Shale		
772 - 800	Anhydrite		
800 - 1040	Shale	<u>Top of Formation</u>	
1040 - 1535	Lime		
1535 - 1620	Shale and lime	Anhydrite	772'
1620 - 1945	Lime and shale	Ft. Riley	1040'
1945 - 3250	Shale and lime	Lansing	3587'
3250 - 3662	Lime and shale	Base K.C.	3814'
3662 - 3837	Lime	Marmathon	3892'
3837 - 3937	Lime and shale	Mississippi	4209'
3937 - 4027	Shale	Kinderhook	4549'
4027 - 4145	Lime and shale	Simpson	4652'
4145 - 4208	Shale and lime		
4208 - 4240	Lime		
4240 - 4383	Lime and chert		
4383 - 4490	Lime		
4490 - 4552	Reaming		
4552 - 4652	Lime		
4652 - 4696	Shale		
4654 - 4696	Simpson		
4696 -	Coring		
	T. D.		

RECEIVED
STATE CORPORATION COMMISSION
SEP 8 1959
CONSERVATION DIVISION
Wichita, Kansas

09-08-1959

STATE OF KANSAS

COUNTY OF BARTON ss

T. D. Sweetman, partner of S & S Drilling Company, being first duly sworn on oath says: That I have knowledge of the facts, statements and matters herein contained and the log of the above described well as filed and that the same are true and correct.

T. D. Sweetman

Subscribed and sworn before me this 21st day of May, 1958.

Virgil E. Belford, Jr.
Notary Public, Barton County

My Commission expires April 27, 1961

PLUGGING

File Sec. 33 T 31 R 5W
Book Page 1 Line 42