


STATE OF KANSAS
STATE CORPORATION COMMISSION

Give All Information Completely
Make Required Affidavit
Mail or Deliver Report to:
Conservation Division
State Corporation Commission
211 No. Broadway
Wichita, Kansas

15-077-00178-00-00
WELL PLUGGING RECORD

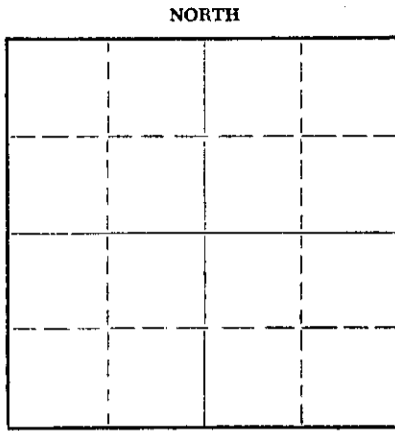

Locate well correctly on above
Section Plat

HARPER County. Sec. 32 Twp. 31S Rge. 5W (E) (W)
Location as "NE/CNW&SW¼" or footage from lines NE SE NE
Lease Owner HERMAN GEO. KAISER & Francis Oil & Gas, Inc.
Lease Name WEDMAN Well No. 1
Office Address 909 Palace Building, Tulsa, Oklahoma
Character of Well (completed as Oil, Gas or Dry Hole) Dry Hole
Date well completed 12-17-57 19____
Application for plugging filed 12-17-57 19____
Application for plugging approved 12-17-57 19____
Plugging commenced 12-17-57 19____
Plugging completed 12-17-57 19____
Reason for abandonment of well or producing formation _____

If a producing well is abandoned, date of last production _____ 19____
Was permission obtained from the Conservation Division or its agents before plugging was commenced? yes

Name of Conservation Agent who supervised plugging of this well unknown
Producing formation _____ Depth to top _____ Bottom _____ Total Depth of Well 4270' Feet
Show depth and thickness of all water, oil and gas formations.

OIL, GAS OR WATER RECORDS

CASING RECORD

FORMATION	CONTENT	FROM	TO	SIZE	PUT IN	PULLED OUT
				8-5/8"	314'	

RECEIVED
STATE CORPORATION COMMISSION
JAN 9 1958
01-09-1958
CONSERVATION DIVISION
Wichita, Kansas

Describe in detail the manner in which the well was plugged, indicating where the mud fluid was placed and the method and casing used in introducing it into the hole. If cement or other plugs were used, state the character of same and depth placed, from _____ feet to _____ feet for each plug set.

Filled with heavy mud to 250', set plug with 20 sacks cement thru drill pipe. Filled with heavy mud to 35', set solid bridge at 35' with 1/3 sack hulls and 10 sacks cement to base of cellar. Plugging Company - K & E DRILLING, INC. Plugging Complete 8:30 p.m. 12-17-57.

(If additional description is necessary, use BACK of this sheet)

Name of Plugging Contractor K & E DRILLING, INC.
Address 719 Union Center, Wichita 2, Kansas

STATE OF Oklahoma COUNTY OF Tulsa, ss.
Berthold Neuwald (employee of owner) ~~owner or operator~~ of the above-described well, being first duly sworn on oath, says: That I have knowledge of the facts, statements, and matters herein contained and the log of the above-described well as filed and that the same are true and correct. So help me God.

HERMAN GEO. KAISER
OIL PRODUCER
(Signature) _____

SUBSCRIBED AND SWORN TO before me this 7th day of January, 1958

My commission expires July 9, 1960

L Ray Hale
Notary Public.

PLUGGING
FILE SEC 32 T 31 R 5W
BOOK PAGE 70 LINE 40

15-077-00178-00-00

WELL LOG

OPERATOR:	HERMAN GEO. KAISER 909 Palace Building Tulsa, Oklahoma	FARM NAME:	#1 WEDMAN
CONTR:	K & E DRILLING, INC. 719 Union Center Wichita 2, Kansas	LOCATION:	NE SE NE, Sec. 32-31S-5W Harper County, Kansas
CASING:	8-5/8" @ 314' (250 sx)	COMMENCED:	12-6-57
R.T.D.	4270'	COMPLETED:	12-17-57
		PRODUCTION:	D & A
		ELEVATION:	1338' KB

FORMATION RECORD

Depths shown indicate bottom of formations encountered

Surface Soil & Clay	15
Sand	40
Red Bed & Shale	100
Shale & Shells	935
Anhydrite	950
Shale & Shells	985
Lime & Shale	1185
Shale & Lime	1365
Lime & Shale	1760
Lime	1930
Shale & Lime	2315
Lime & Shale	2640
Shale & Lime	2980
Lime & Shale	3130
Lime	3194
Shale & Lime	3310
Shale	3348
Sand	3435
Shale	3601
Lime	3855
Shale & Lime	3925
Lime & Shale	4050
Lime	4100
Lime & Shale	4145
Shale & Lime	4217
Lime (Miss)	4270
R.T.D.	4270

RECEIVED
STATE CORPORATION COMMISSION
JAN 9 1958
CONSERVATION DIVISION
Wichita, Kansas
01-09-1958

CERTIFICATION

STATE OF KANSAS)
COUNTY OF SEDGWICK) SS:

I, Dale Silcott of K & E DRILLING, INC., upon my oath state that the above and foregoing is a true and correct copy of the Driller's Log of the HERMAN KAISER #1 WEDMAN well.

Dale Silcott
Dale Silcott

Subscribed and sworn to before me this 3rd day of January, 1958.

Patricia M. Edwards
Patricia M. Edwards, Notary Public

My commission expires: 11 August 1958.

PLUGGING
FILE SEC 32 T 31 R 5W
BOOK PAGE 70 LINE 40