


WELL PLUGGING RECORD

Give All Information Completely
Make Required Affidavit
Mail or Deliver Report to:
Conservation Division
State Corporation Commission
211 No. Broadway
Wichita, Kansas

Rush County. Sec. 8 Twp. 17 Rge. 20W (E) (W)

Location as "NE/CNW/SW" or footage from lines NW NE NW
Lease Owner DUNBAR DRILLING INC.
Lease Name Fabst Well No. 1
Office Address 5252 North Broadway Wichita, Kansas 67219
Character of Well (completed as Oil, Gas or Dry Hole) oil
Date well completed _____ 19____
Application for plugging filed 5/23/74 19____
Application for plugging approved 5/23/74 19____
Plugging commenced 8-17-74 19____
Plugging completed 8-23-74 19____
Reason for abandonment of well or producing formation oil depleted

NORTH

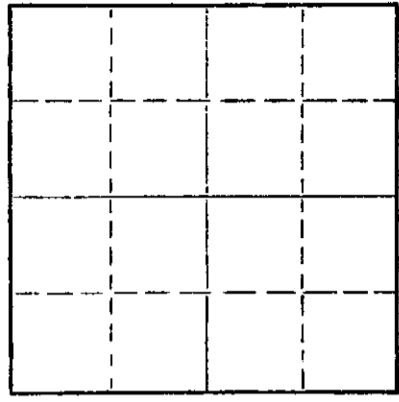

Locate well correctly on above Section Plat

If a producing well is abandoned, date of last production _____ 19____
Was permission obtained from the Conservation Division or its agents before plugging was commenced? yes

Name of Conservation Agent who supervised plugging of this well Leo Massey
Producing formation _____ Depth to top _____ Bottom _____ Total Depth of Well 4050 Feet
Show depth and thickness of all water, oil and gas formations.

OIL, GAS OR WATER RECORDS

CASING RECORD

FORMATION	CONTENT	FROM	TO	SIZE	PUT IN	PULLED OUT

Describe in detail the manner in which the well was plugged, indicating where the mud fluid was placed and the method or methods used in introducing it into the hole. If cement or other plugs were used, state the character of same and depth placed, from _____ feet to _____ feet for each plug set.

Rock bridge to 3970 sand back to 3940 5 sax cement lay out pipe
pump 17 sax mud 1 sax hulls 70 sax cement 6 sax mud gel 20 sax cement

RECEIVED
STATE CORPORATION COMMISSION
SEP 23 1974
CONSERVATION DIVISION
Wichita, Kansas

09-23-1974

(If additional description is necessary, use BACK of this sheet)
Name of Plugging Contractor DUNBAR DRILLING INC.
Address 5252 North Broadway Wichita, Kansas 67219

STATE OF Kansas COUNTY OF Sedgwick, ss.
W. P. SIMMONS (employee of owner) or (owner or operator) of the above-described well, being first duly sworn on oath, says: That I have knowledge of the facts, statements, and matters herein contained and the log of the above-described well as filed and that the same are true and correct. So help me God.

(Signature) W. P. Simmons
5252 North Broadway Wichita, Kas 67219
(Address)

SUBSCRIBED AND SWORN TO before me this 19th day of September, 19 74

My commission expires November 19, 1977
Frances J. Simmons Notary Public.

