


STATE OF KANSAS  
STATE CORPORATION COMMISSION

Give All Information Completely  
Make Required Affidavit  
Mail or Deliver Report to:  
Conservation Division  
State Corporation Commission  
212 No. Market  
Wichita, Kansas

WELL PLUGGING RECORD

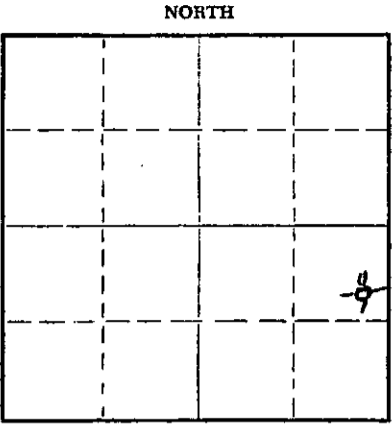

Locate well correctly on above  
Section Plat

Rush County, Sec. 1 Twp. 17 Rge. 20 (E) W (W)  
Location as "NE/CNW/SW" or footage from lines SE NE SE  
Lease Owner Birmingham-Bartlett Drilling Company  
Lease Name Baldwin "B" Well No. 3  
Office Address Kaufman Building - Wichita, Kansas 67202  
Character of Well (completed as Oil, Gas or Dry Hole) D & A  
Date well completed June 29 1968  
Application for plugging filed June 29 1968  
Application for plugging approved June 29 1968  
Plugging commenced June 29 1968  
Plugging completed June 29 1968  
Reason for abandonment of well or producing formation D & A

If a producing well is abandoned, date of last production 19  
Was permission obtained from the Conservation Division or its agents before plugging was commenced? Yes

Name of Conservation Agent who supervised plugging of this well Leo F. Massey  
Producing formation \_\_\_\_\_ Depth to top \_\_\_\_\_ Bottom \_\_\_\_\_ Total Depth of Well 3868 Feet  
Show depth and thickness of all water, oil and gas formations.

OIL, GAS OR WATER RECORDS

CASING RECORD

FORMATION	CONTENT	FROM	TO	SIZE	PUT IN	PULLED OUT
				8 5/8"	251.57'	-0-

Describe in detail the manner in which the well was plugged, indicating where the mud fluid was placed and the method or methods used in introducing it into the hole. If cement or other plugs were used, state the character of same and depth placed, from \_\_\_\_\_ feet to \_\_\_\_\_ feet for each plug set.

Swedge in surface pipe 1  
plug 2 sx hulls with water.  
130 sx 50-50 posmix, 6% gel  
400 lbs. to break down 100  
lbs. press at completion

RECEIVED  
STATE CORPORATION COMMISSION  
JUL 3 1968  
CONSERVATION DIVISION  
Wichita, Kansas  
07-03-1968

(If additional description is necessary, use BACK of this sheet)  
Name of Plugging Contractor Red Tiger Drilling Company  
Address 1720 Wichita Plaza - Wichita, Kansas 67202

STATE OF KANSAS, COUNTY OF SEDGWICK, ss.  
Harold R. Martin (employee of owner) or (owner or operator) of the above-described well, being first duly sworn on oath, says: That I have knowledge of the facts, statements, and matters herein contained and the log of the above-described well as filed and that the same are true and correct. So help me God.

(Signature) Harold R. Martin  
1720 Wichita Plaza, Wichita, Kansas  
(Address)

SUBSCRIBED AND SWORN to before me this 1st day of July, 19 68

My commission expires 3-22-71

Betty M. Maloney Notary Public.

15-145-20164-00-00

DRILLERS LOG

No. 3 Baldwin "B"

CASING RECORD:

8 5/8" @ 251.57'  
w/165 sx cement

TOTAL DEPTH: 3868'

COMPANY:

Birmingham-Bartlett Drilling Co.

CONTRACTOR:

Red Tiger Drilling Company

COMMENCED:

June 20, 1968

COMPLETED:

June 29, 1968

DESCRIPTION

SE NE SE  
1-17S-20W  
Rush Co.,  
Kansas

ELEVATION:

<u>FORMATION</u>	<u>FROM</u>	<u>TO</u>	<u>REMARKS</u>
Clay and shale	0	130	
Shale	130	710	
Sand	710	975	
Shale	975	1298	
Anhydrite	1298	1330	
Shale	1330	2130	
Lime and shale	2130	2290	
Lime	2290	2415	
Lime and shale	2415	2810	
Lime	2810	2945	
Lime and shale	2945	3008	
Lime	3008	3105	
Lime and shale	3105	3240	
Lime	3240	3868	

RECEIVED  
STATE CORPORATION COMMISSION  
JUL 3 1968  
CONSERVATION DIVISION  
Wichita, Kansas  
07-03-1968

I certify that this is a true and correct copy of the above log to the best of my knowledge.

RED TIGER DRILLING COMPANY

Harold R. Martin  
Harold R. Martin

Subscribed and sworn to before me this 1st day of July, 1968.

Betty M. Maloney  
Notary Public

My Commission Expires:

3-22-71