


STATE OF KANSAS
STATE CORPORATION COMMISSION

15-165-20338-00-00 Form CP-4

Give All Information Completely
Make Required Affidavit
Mail or Deliver Report to:
Conservation Division
State Corporation Commission
211 No. Broadway
Wichita, Kansas

WELL PLUGGING RECORD

NORTH

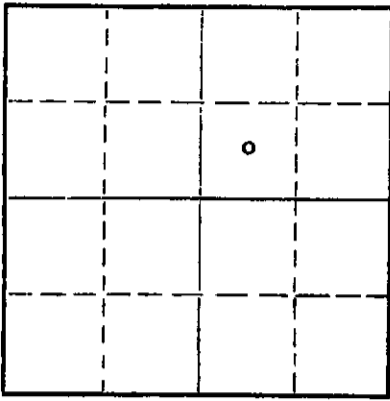

Locate well correctly on above
Section Plat

Rush County. Sec. 8 Twp. 17S Rge. 20W (E) (W)
Location as "NE/CNWKSWK" or footage from lines C SW NE
Lease Owner John Eaton
Lease Name Shiney Well No. 1
Office Address Shields, Kansas 67874
Character of Well (completed as Oil, Gas or Dry Hole) Dry Hole
Date well completed August 6 19 70
Application for plugging filed August 6 19 70
Application for plugging approved August 6 19 70
Plugging commenced August 6 19 70
Plugging completed August 6 19 70
Reason for abandonment of well or producing formation Dry Hole

If a producing well is abandoned, date of last production _____ 19 ____
Was permission obtained from the Conservation Division or its agents before plugging was commenced? Yes

Name of Conservation Agent who supervised plugging of this well Eldon Petty, Hays, Kansas
Producing formation _____ Depth to top _____ Bottom _____ Total Depth of Well 4105 Feet
Show depth and thickness of all water, oil and gas formations.

OIL, GAS OR WATER RECORDS

CASING RECORD

| FORMATION | CONTENT | FROM | TO | SIZE | PUT IN | PULLED OUT |
|-----------|---------|------|------|--------|--------|------------|
| | | 0 | 463' | 8 5/8" | 463' | None |
| | | | | | | |
| | | | | | | |
Describe in detail the manner in which the well was plugged, indicating where the mud fluid was placed and the method or methods used in introducing it into the hole. If cement or other plugs were used, state the character of same and depth placed, from _____ feet to _____ feet for each plug set.

Plug: 435'/30 sacks cement
40'/solid bridge and 10 sacks cement

RECEIVED
STATE CORPORATION COMMISSION
AUG 19 1970
CONSERVATION DIVISION
Wichita, Kansas

08-19-1970

(If additional description is necessary, use BACK of this sheet)

Name of Plugging Contractor Hellar Drilling Company, Inc.
Address 339 Union Center Bldg., Wichita, Kansas 67202

STATE OF Kansas, COUNTY OF Sedgwick, ss.


D. L. Hellar, President of Hellar Drlg. Co. Inc. (employee of owner) or (owner or operator) of the above-described well, being first duly sworn on oath, says: That I have knowledge of the facts, statements, and matters herein contained and the log of the above-described well as filed and that the same are true and correct. So help me God.

(Signature) D. L. Hellar D. L. Hellar, President
339 Union Center Bldg., Wichita, Kansas 67202
(Address)

Subscribed and sworn to before me this 17th day of August, 19 70

My commission expires March 25, 1972

Catherine Darcey
Catherine Darcey
Notary Public.

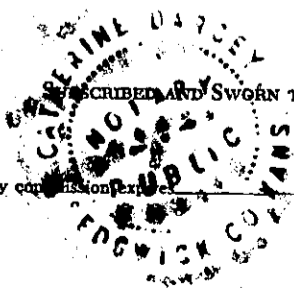

15-165-20338-00-00

DRILLER'S LOG

COMPANY: John Eaton, Shields, Kansas 67874
CONTRACTOR: Hellar Drilling Company, Inc., Wichita, Kansas 67202
LEASE: #1 Shiney
LOCATION: C SW NE 8-17S-20W, Rush County, Kansas
COMMENCED: July 29, 1970
COMPLETED: August 6, 1970
CASING: Set 8 5/8" Surface Casing @ 463'/260 sacks cement

| | |
|-----------|------------------------|
| 0-90 | Clay, Shale & Rock |
| 90-325 | Shale |
| 325-463 | Shale, some Red Bed |
| 463-1370 | Shale - Sand & Red Bed |
| 1370-1406 | Anhydrite |
| 1406-1810 | Red Bed & Shale |
| 1810-2050 | Shale |
| 2050-2185 | Shale & Lime |
| 2185-3655 | Lime & Shale |
| 3655-3704 | Lime (L.K.C.) |
| 3704-3953 | Lime |
| 3953-3994 | Lime & Chert |
| 3994-4000 | Lime |
| 4000-4015 | Cherokee |
| 4015-4090 | Shale & Chert |
| 4090-4105 | Lime |
| 4105 | Rotary Total Depth |

RECEIVED
 STATE CORPORATION COMMISSION
 AUG 19 1970
 CONSERVATION DIVISION
 Wichita, Kansas

08-19-1970

D & A


State of Kansas)
) SS
 County of Sedgwick)

I, D. L. Hellar, do hereby certify that the above and foregoing is a true and correct copy of the log of the #1 Shiney, located in c SW NE 8-17S-20W, Rush County, Kansas as reflected by the files of the Hellar Drilling Company, Inc.

HELLAR DRILLING COMPANY, INC.

By *D. L. Hellar*
 President - D. L. Hellar

Subscribed and sworn to before me, a Notary Public, in and for Sedgwick County, Kansas, this 17th day of August, 1970.

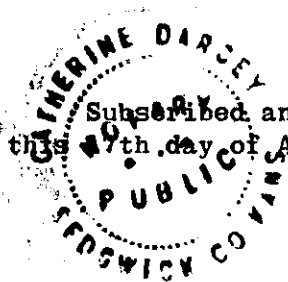

Catherine Darcey
 Notary Public - Catherine Darcey

My Commission Expires:
 March 25, 1972.