


Give All Information Completely  
Make Required Affidavit  
Mail or Deliver Report to:  
Conservation Division  
State Corporation Commission  
212 No. Market  
Wichita, Kansas

WELL PLUGGING RECORD

NORTH

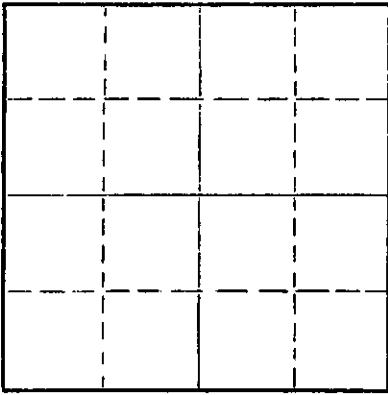

Locate well correctly on above  
Section Plat

Rush County, Sec. 8 Twp. 17S Rge. 20 (E) W (W)  
Location as "NE/CNW/SW" or footage from lines SE SW  
Lease Owner McClure Oil Company  
Lease Name Golf Course Well No. 1  
Office Address 1301 Plaza Building - Wichita, Kansas 67202  
Character of Well (completed as Oil, Gas or Dry Hole) D & A  
Date well completed June 24 1968  
Application for plugging filed June 24 1968  
Application for plugging approved June 24 1968  
Plugging commenced June 24 1968  
Plugging completed June 24 1968  
Reason for abandonment of well or producing formation D & A

If a producing well is abandoned, date of last production 19  
Was permission obtained from the Conservation Division or its agents before plugging was commenced? Yes

Name of Conservation Agent who supervised plugging of this well Leo F. Massey  
Producing formation Depth to top Bottom Total Depth of Well 4016 Feet  
Show depth and thickness of all water, oil and gas formations.

OIL, GAS OR WATER RECORDS

CASING RECORD

FORMATION	CONTENT	FROM	TO	SIZE	PUT IN	PULLED OUT
				8 5/8"	460.46'	-0-

Describe in detail the manner in which the well was plugged, indicating where the mud fluid was placed and the method or methods used in introducing it into the hole. If cement or other plugs were used, state the character of same and depth placed, from feet to feet for each plug set.

Lay down drill pipe, plug  
hole with 50 sx @ 450' 10  
sx at 40' job completed

07-08-1968  
RECEIVED  
STATE CORPORATION COMMISSION  
JUL 8 1968  
CONSERVATION DIVISION  
Wichita, Kansas

(If additional description is necessary, use BACK of this sheet)

Name of Plugging Contractor Red Tiger Drilling Company  
Address 1720 Wichita Plaza - Wichita, Kansas 67202

STATE OF KANSAS, COUNTY OF SEDGWICK, ss.  
Harold R. Martin (employee of owner) or (owner or operator) of the above-described well, being first duly sworn on oath, says: That I have knowledge of the facts, statements, and matters herein contained and the log of the above-described well as filed and that the same are true and correct. So help me God.

(Signature) Harold R. Martin  
1720 Wichita Plaza - Wichita, Kansas  
(Address)

SUBSCRIBED AND SWORN TO before me this 28th day of June, 1968

My commission expires 3-22-71 Notary Public.

15-165-20161-00-00

DRILLERS LOG

Golf Course No. 1

CASING RECORD: 8 5/8" @ 460.46' w/300 sx cement  
TOTAL DEPTH: 4016'

COMPANY: McClure Oil Company  
CONTRACTOR: Red Tiger Drilling Company  
COMMENCED: June 14, 1968  
COMPLETED: June 24, 1968

DESCRIPTION: SE SW of 8-17S-20W Rush Co., Kansas  
ELEVATION:

<u>FORMATION</u>	<u>FROM</u>	<u>TO</u>	<u>REMARKS</u>
Clay and shale	0	40	
Shale and sand	40	400	
Shale and hard sand	400	464	
Shale	464	665	
Red bed and sand	665	787	
Sand	787	1056	
Red bed and shale	1056	1285	
Shale	1285	1366	
Anhydrite	1366	1398	
Shale	1398	1615	
Shale and shells	1616	2100	
Shale and lime	2100	2275	
Lime	2275	2405	
Lime and shale	2405	3555	
Lime	3555	3995	
Sand	3995	3998	
Lime and sand and chert	3998	4007	
Lime and chert	4007	4012	
lime and sand and chert	4012	4016	

RECEIVED  
STATE CORPORATION COMMISSION  
JUL 8 1968  
CONSERVATION DIVISION  
Wichita, Kansas

07-08-1968

I certify that this is a true and correct copy of the above log to the best of my knowledge.

RED TIGER DRILLING COMPANY

Harold R. Martin  
Harold R. Martin

Subscribed and sworn to before me this 28th day of June, 1968.

Betty M. Maloney  
Notary public

My Commission Expires:

3-22-71