

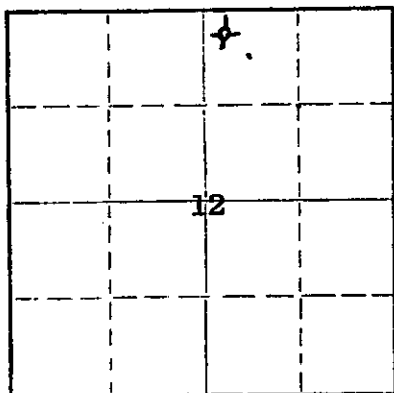
15-165-20168-00-00

Form CP-4

STATE OF KANSAS
STATE CORPORATION COMMISSIONGive All Information Completely
Make Required Affidavit
Mail or Deliver Report to:
Conservation Division
State Corporation Commission
212 No. Market
Wichita, Kansas

WELL PLUGGING RECORD

NORTH

Locate well correctly on above
Section Plat

Rush

County, Sec. 12 Twp. 17S Rge. (E) 20 (W)

Location as "NE/CNW/SW" or footage from lines C NW NW NE

Lease Owner Rains & Williamson Oil Co., Inc.

Lease Name TEMPLE Well No. 1

Office Address 1425 Wichita Plaza - Wichita, Kansas 67202

Character of Well (completed as Oil, Gas or Dry Hole) Dry Hole

Date well completed 7-31 19 68

Application for plugging filed 7-31 19 68

Application for plugging approved 7-31 19 68

Plugging commenced 7-31 19 68

Plugging completed 4:30 PM 7-31 19 68

Reason for abandonment of well or producing formation No oil or gas
found in commercial quantities.

If a producing well is abandoned, date of last production -- 19 --

Was permission obtained from the Conservation Division or its agents before plugging was commenced? Yes

Name of Conservation Agent who supervised plugging of this well Bill Nichols, Moreland, Kansas

Producing formation Depth to top Bottom Total Depth of Well 3871 Feet

Show depth and thickness of all water, oil and gas formations.

OIL, GAS OR WATER RECORDS

CASING RECORD

FORMATION	CONTENT	FROM	TO	SIZE	PUT IN	PULLED OUT
				8-5/8"	256'	-0-

Describe in detail the manner in which the well was plugged, indicating where the mud fluid was placed and the method or methods used in introducing it into the hole. If cement or other plugs were used, state the character of same and depth placed, from feet to feet for each plug set.

Spotted 70 sacks 50-50 pozmix, 6% gel, at 600'.
Spotted 20 sacks same at 270'. Mud back to 40'.
Set solid bridge and capped with 10 sacks; 2 sacks
in rat hole. Plugging completed 4:30 PM 7-31-68.STATE OF KANSAS
RECEIVED
CONSERVATION COMMISSION
AUG 6 1968
CONSERVATION DIVISION
Wichita, Kansas

08-06-1968

(If additional description is necessary, use BACK of this sheet)

Name of Plugging Contractor Rains & Williamson Oil Co., Inc.
Address 1425 Wichita Plaza - Wichita, Kansas 67202STATE OF KANSAS COUNTY OF SEDGWICK, SS.
Wilson Rains

(owner or operator) of the above-described well, being first duly sworn on oath, says: That I have knowledge of the facts, statements, and matters herein contained and the log of the above-described well as filed and that the same are true and correct. So help me God.

(Signature) Wilson Rains Wilson Rains

1425 Wichita Plaza - Wichita, Kansas
(Address)

SUBSCRIBED AND SWORN TO before me this 5th day of August, 1968

My commission expires June 30, 1971

Sherry Gish Notary Public.

15-165 - 20168-00-00

ROTARY DRILLING LOG

Operator: Rains & Williamson
Oil Co., Inc.
TEMPLE #1
C NW NW NE 12-17S-20W
Rush County, Kansas

Contractor: Rains & Williamson
Oil Co., Inc.
Commenced: 7-22-68
Completed: 7-31-68
Remarks: 8-5/8" @ 256'/155 sx.

Formations

Surface Soil & Shale	160'
Shale	710'
Sand	975'
Shale and Red Bed	1296'
Anhydrite	1331'
Shale	2000'
Lime and Shale	2260'
Lime	2385'
Lime and Shale	2485'
Shale and Lime	3340'
Lime	3790'
Lime and Chert	3815'
Lime	3871'

Rotary Total Depth (D&A) 3871'

RECEIVED
STATE CORPORATION COMMISSION
AUG 6 1968
CONSERVATION DIVISION
Topeka, Kansas

08-06-1968

We certify the above log is true
and correct, to the best of our
knowledge and belief.

RAINS & WILLIAMSON OIL CO., INC.

Jerald W. Rains
Jerald W. Rains

Subscribed and sworn to before me, a Notary Public within and for the
State of Kansas, County of Sedgwick, this 5 day of August, 1968.

Sherry Gish
Sherry Gish Notary Public

My Commission Expires:
June 30, 1971

