


Give All Information Completely
Make Required Affidavit
Mail or Deliver Report to:
Conservation Division
State Corporation Commission
212 No. Market
Wichita, Kansas

WELL PLUGGING RECORD

Rush County, Sec. 35 Twp. 17 Rge. 20 (S) (W)

Location as "NE/CNWxSWx" or footage from lines C NE SW
Lease Owner Neven H. Veal
Lease Name Paul Bott Well No. 1
Office Address 1401 McKinley, Great Bend, Kansas 67530
Character of Well (completed as Oil, Gas or Dry Hole) Dry Hole
Date well completed 2-10 1968
Application for plugging filed 19 1968
Application for plugging approved 19 1968
Plugging commenced 19 1968
Plugging completed 19 1968
Reason for abandonment of well or producing formation Dry Hole

NORTH

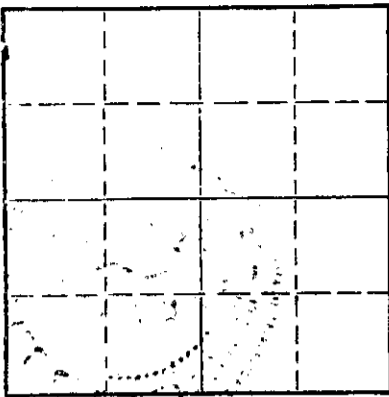

Locate well correctly on above Section Plat

If a producing well is abandoned, date of last production _____ 19____
Was permission obtained from the Conservation Division or its agents before plugging was commenced? Yes

Name of Conservation Agent who supervised plugging of this well Leo Massey
Producing formation _____ Depth to top _____ Bottom _____ Total Depth of Well _____ Feet
Show depth and thickness of all water, oil and gas formations.

OIL, GAS OR WATER RECORDS

CASING RECORD

FORMATION	CONTENT	FROM	TO	SIZE	PUT IN	PULLED OUT

Describe in detail the manner in which the well was plugged, indicating where the mud fluid was placed and the method or methods used in introducing it into the hole. If cement or other plugs were used, state the character of same and depth placed, from _____ feet to _____ feet for each plug set.

4070 - 540 - Heavy rotary mud
540 - 70 sacks cement
540 - 270 - Heavy rotary mud
270 - 20 sacks cement
270 - 40 - Heavy rotary mud
40 - GL - 10 sacks cement

Plugged by Allied Cement Company truck.

RECEIVED
STATE CORPORATION COMMISSION

FEB 16 1968

CONSERVATION DIVISION
Wichita, Kansas

02-16-1968

(If additional description is necessary, use BACK of this sheet)
Name of Plugging Contractor Peel Brothers, Inc.
Address Box 359, Hoisington, Kansas 67544

STATE OF Kansas, COUNTY OF Barton, ss.

Peel Brothers, Inc. (employee of owner) ~~owner~~ of the above-described well, being first duly sworn on oath, says: That I have knowledge of the facts, statements, and matters herein contained and the log of the above-described well as filed and that the same are true and correct. So help me God. PEEL BROTHERS, INC.

(Signature) Wendell C. Peel
Wendell C. Peel, President

(Address)

SUBSCRIBED AND SWORN TO before me this 12th day of February, 19 68

My commission expires 6-21-70

Ethel S. Williamson
Ethel S. Williamson
Notary Public.

15-165-2015-00-00

DRILLER'S LOG

Well Owner:	Neven H. Veail	
Farm Name:	Paul Bott No. 1	C NE SW
Date Started:	1-31-68	Section 35-17S-20W
Date Completed:	2-10-68	Rush County, Kansas
Total Depth:	4070	

Casing: 8-5/8" set at 273' cemented

Contractor: Peel Brothers, Inc.

Figures below show bottoms of formations:

Post Rock and Clay	0	- 75
Shale		665
Red Bed		685
Sand		990
Red Bed and Shells		1334
Anhydrite		1366
Shale and Shells		1918
Shale and Lime		2365
Lime and Shale		3390
Lime		4070
Total Depth		4070

This is to certify that the above information is to the best of our knowledge true and correct.

PEEL BROTHERS, INC.

Wendell C. Peel
President



SUBSCRIBED AND SWORN to before me this 12th day of February, 1968.

Ethel S. Williamson
Ethel S. Williamson
Notary Public

RECEIVED
STATE CORPORATION COMMISSION

FEB 16 1968

CONSERVATION DIVISION
Wichita, Kansas

My Commission expires 6-21-70

02-16-1968