


STATE OF KANSAS
STATE CORPORATION COMMISSION

Form CP-4

Give All Information Completely
Make Required Affidavit
Mail or Deliver Report to:
Conservation Division
State Corporation Commission

WELL PLUGGING RECORD

P. O. Box 17027
Wichita, Kansas 67217
NORTH

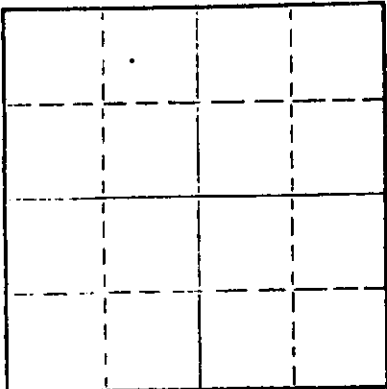

Locate well correctly on above
Section Plat

Rush County, Sec 24 Twp 18 Rge 16 (E) (W)
Location as "NE/CNW/SW" or footage from lines N 2 - N 2 - NW
Lease Owner B. F. Johnson
Lease Name ~~Brack~~ Vernon Brack Well No. 1
Office Address Box 81 Great Bend Kansas
Character of Well (completed as Oil, Gas or Dry Hole) GAS
Date well completed Jan. 19 69
Application for plugging filed 4 / 26 19 74
Application for plugging approved 19
Plugging commenced 4 / 24 19 74
Plugging completed 5 / 6 19 74
Reason for abandonment of well or producing formation DRY

If a producing well is abandoned, date of last production 19 69
Was permission obtained from the Conservation Division or its agents before plugging was commenced? yes

Name of Conservation Agent who supervised plugging of this well Leo F. Massey
Producing formation Tronto Depth to top 2350 Bottom 2360 Total Depth of Well 2360 Feet
Show depth and thickness of all water, oil and gas formations.

OIL, GAS OR WATER RECORDS

CASING RECORD

FORMATION	CONTENT	FROM	TO	SIZE	PUT IN	PULLED OUT
	Surface	0	950	7"		
		0 1/2	2360	4 1/2"		1610

Describe in detail the manner in which the well was plugged, indicating where the mud fluid was placed and the method or methods used in introducing it into the hole. If cement or other plugs were used, state the character of same and depth placed, from _____ feet to _____ feet for each plug set.

Push plug to 2300 - 10 ft sand 4 sx cement
Pumped in 2hulls 15 jell and 90 sx cement under 1000# pressure
Job complete At 12 noon 5-6-74

RECEIVED
STATE CORPORATION COMMISSION
MAY 8 - 1974
CONSERVATION DIVISION
Wichita, Kansas

(If additional description is necessary, use BACK of this sheet)

Name of Plugging Contractor _____
Address _____

STATE OF KANSAS COUNTY OF RICE ss.
George A. Nicholas (employee of owner) or (owner or operator) of the above-described

well being first duly sworn on oath, says: That I have knowledge of the facts, statements, and matters herein contained and the log of the above-described well as filed and that the same are true and correct. So help me God.

(Signature) George A. Nicholas

(Address) _____

Sworn to before me this 7th day of May, 19 74

September 24, 1974

Warren H. Laughlin Notary Public.

