

WELL PLUGGING RECORD

STATE OF KANSAS
STATE CORPORATION COMMISSION


Give All Information Completely
Make Required Affidavit
Mail or Deliver Report to:
Conservation Division
State Corporation Commission
800 Bittling Building
Wichita, Kansas

OR

FORMATION PLUGGING RECORD

Strike out upper line
when reporting plug-
ging off formations.

Rush County. Sec. 22 Twp. 18 Rge. 16 (E) (W)
Location as "NE $\frac{1}{4}$ NW $\frac{1}{4}$ SW $\frac{1}{4}$ " or footage from lines. 990 north line 220 East line
Lease Owner. Kenwood Oil Co
Lease Name. maneth Well No. 9
Office Address. Wichita, Kas
Character of Well (completed as Oil, Gas or Dry Hole) Oil
Date well completed. 1-20-47 19
Application for plugging filed. 8-28-47 19
Application for plugging approved. 19
Plugging commenced. 2-5-47 19
Plugging completed. 9-18-47 19
Reason for abandonment of well or producing formation.

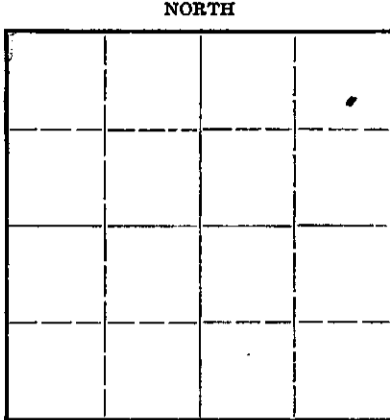

Locate well correctly on above
Section Plat

Name of Conservation Agent who supervised plugging of this well. John Kern
Producing formation. 2527-3343 Depth to top. Bottom. Total Depth of Well. 3573 Feet
Show depth and thickness of all water, oil and gas formations. alg pack 3341

OIL, GAS OR WATER RECORDS

CASING RECORD

Formation	Content	From	To	Size	Put In	Pulled Out
			117-7	12 1/2	Cemented	
			989-2	8 3/8		
			3443	5 1/2		2000

Describe in detail the manner in which the well was plugged, indicating where the mud fluid was placed and the method or methods used in introducing it into the hold. If cement or other plugs were used, state the character of same and depth placed, from.....feet to.....feet for each plug set.

Cement plug 3341-3400
mud 3400-1015
Cement 1015-985
mud 985-200
Cement - 200-2000

(If additional description is necessary, use BACK of this sheet)

Correspondence regarding this well should be addressed to.....
Address.....

9-24-47
1947

STATE OF Kansas, COUNTY OF Barton, ss.
Olaf Williams (employee of owner) or townor or operator) of the above-described well,
being first duly sworn on oath, says: That I have knowledge of the facts, statements, and matters herein contained and the log of the above-described well as filed and that the same are true and correct. So help me God.

(Signature) Olaf Williams
(Address) Wichita Kan

SUBSCRIBED AND SWORN to before me this 23th day of September, 1947

NOTARY PUBLIC

Term Expires January 20th, 1949

Notary Public.

My commission expires.....

PLUGGING
FILE SEC 22-T-18-R-16W
BOOK PAGE 129 LINE 17

15-165-02120-0000

COPY

SCHERMERHORN-WINTON COMPANY

MANETH WELLS NO. 3

NE $\frac{1}{4}$ of Section 22-18S-16W

Rush County, Kansas

Drilling commenced: 1-3-40

Drilling completed: 1-26-40

12 1/2" - 117'-7" Cemented

8 5/8" - 989-9" "

5 1/2" - 3543' "

FROM	TO	FORMATION	REMARKS
0	70	Sand	
70	400	shale and shells	Cemented 117'-7" of 12 1/2" casing with 80 sacks cement, 4 sacks aquagel, 2 sacks Cal.Chloride.
400	410	shale	
410	510	sand	
510	640	shale and sand	
640	888	red rock	
888	987	shale	Cemented 989-8" of 8-5/8" Casing with 250 Sacks
987	1015	anhydrite	Incor cement and 10 sacks Aquagel.
1015	1160	shale and red beds	
1160	1200	red rock	
1200	1210	anhydrite	
1210	1340	shale	
1340	1425	shale and lime shells	
1425	1468	salt and broken lime	
1468	1575	salt and shells	
1575	1710	shale and shells	
1710	1775	shale	
1775	1835	shale and lime shells	
1835	1918	broken lime	
1918	1985	lime	
1985	2000	broken lime	
2000	2198	lime	
2198	2300	lime and shells	
2300	2388	broken lime	
2388	2425	lime	
2425	2475	broken lime	
2475	2518	lime	
2518	2627	shale and shells	
2627	2775	shale	
2775	2827	lime shells and shale	
2827	2930	lime	
2930	3177	Topeka lime	
3177	3227	broken lime	
3227	3250	lime	
3250	3296	K.C.lime	
3296	3358	lime	
3358	3366	lime and chert	
3366	3381	shale	
3381	3444	lime	
3444	3505	lime and shale	
3505	3524	shale	
3524	3527	lime and sand	
3527	3543	sand and shale-cored	5-1/2" OD casing cemented at 3543 with 250 sacks cement.
3543	3550	lime	
3550	3573	sand	

Plugged back to 3561 feet;

Shooting - Lane wells 3506 - 3518
17 M Ft. Gas.

