


STATE OF KANSAS
STATE CORPORATION COMMISSION

Give All Information Completely
Make Required Affidavit
Mail or Deliver Report to:
Conservation Division
State Corporation Commission
211 No. Broadway
Wichita, Kansas

WELL PLUGGING RECORD

NORTH

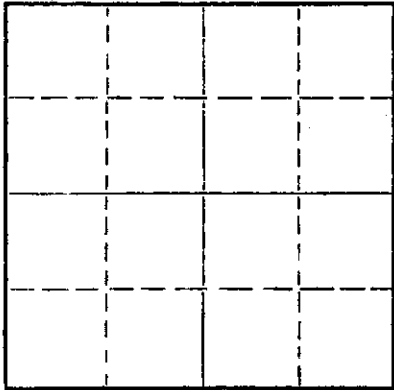

Locate well correctly on above
Section Plat

Rush County. Sec. 22 Twp. 18 Rge. (E) 16 (W)
Location as "NE/CNW/SW" or footage from lines Center of West Line of NW 1/4 of SW 1/4
Lease Owner Solar Oil Company
Lease Name Ater Well No. 1
Office Address 1117 Union Nat'l. Bank Bldg., Wichita, Kansas
Character of Well (completed as Oil, Gas or Dry Hole) Dry Hole
Date well completed 10-26-1956
Application for plugging filed 10-26-1956
Application for plugging approved 10-26-1956
Plugging commenced 10-26-1956
Plugging completed 10-26-1956
Reason for abandonment of well or producing formation _____

If a producing well is abandoned, date of last production _____ 19____
Was permission obtained from the Conservation Division or its agents before plugging was commenced? Yes

Name of Conservation Agent who supervised plugging of this well R. M. Brundege
Producing formation _____ Depth to top _____ Bottom _____ Total Depth of Well 3550 Feet
Show depth and thickness of all water, oil and gas formations.

OIL, GAS OR WATER RECORDS

CASING RECORD

FORMATION	CONTENT	FROM	TO	SIZE	PUT IN	PULLED OUT
				8 5/8"	1010'	-0-

Describe in detail the manner in which the well was plugged, indicating where the mud fluid was placed and the method or methods used in introducing it into the hole. If cement or other plugs were used, state the character of same and depth placed, from _____ feet to _____ feet for each plug set.

Ran heavy mud to 350'. Set bottom plug with 1/3 sk Hulls. and 20 sacks cement. Filled with mud to 40'. Set top plug with 1/3 sack hulls and 10 sacks cement. Filled to bottom of cellar.

RECEIVED
STATE CORPORATION COMMISSION
NOV 3 1956
CONSERVATION DIVISION
Wichita, Kansas

(If additional description is necessary, use BACK of this sheet)

Name of Plugging Contractor Lewis Drilling Company
Address 915 Union Center, Wichita, Kansas

STATE OF KANSAS COUNTY OF SEDGWICK ss.
J. Fred Hambright (employee of owner/lessee/operator) of the above-described well, being first duly sworn on oath, says: That I have knowledge of the facts, statements, and matters herein contained and the log of the above-described well as filed and that the same are true and correct. So help me God.

(Signature) J. Fred Hambright
915 Union Center, Wichita, Kansas
(Address)

SUBSCRIBED AND SWORN TO before me this 31st day of October, 19 56

My commission expires August 20, 1960 A. R. Derrington Notary Public.

PLUGGING
FILE SEC 22 T. 18 R. 16 W
BOOK PAGE 111 LINE 13

15-165-01803-0000
WELL LOG

COMPANY Solar Oil Company

SEC. 22 T. 18S R. 16W
LOC. Center of West line of
NW 1/4 of SW 1/4

FARM Ater

NO. 1

TOTAL DEPTH 3550'

COMM. 10-14-56


COMP. 10-26-56

SHOT OR TREATED

CONTRACTOR Lewis Drilling Company

ISSUED

COUNTY Rush
KANSAS

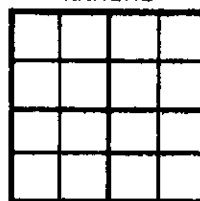

ELEVATION 1956 KB

PRODUCTION

CASING

20	10
15	8 5/8" -1010'
12	6
13	5

FIGURES INDICATE BOTTOM OF FORMATIONS

0 - 380	Surface Soil & Shale
380 - 455	Sand and Shale
455 - 690	Sand and Red Beds
690 - 1000	Red Beds and Shale
1000 - 1025	Anhydrite
1025 - 1410	Red Beds and Shale
1410 - 3170	Lime and Shale
3170 - 3550	Lime
3550	T. D.

Geologic Tops:

Heebner	3166'
Lansing	3227'
Reagan	3611'

RECEIVED
STATE COMMISSION
NOV 3 1956
11-3-56
COMMISSIONER
GEOLOGICAL SURVEY

PLUGGING
FILE SEC. 22 T. 18 R. 16W
BOOK PAGE 111 LINE 13

State of KANSAS }
County of SEDGWICK } ss:

I, J. Fred Hambright of the Lewis Drilling Company
upon oath state that the above and foregoing is a true and correct copy of the log of the Ater #1 well.

Subscribed and sworn to before me this 31st day of October 19 56
J. Fred Hambright
(J. Fred Hambright)

My Commission Expires: August 20, 1960

A. R. Derrington
NOTARY PUBLIC
(A. R. Derrington)