

15-165-01830-0000

STATE OF KANSAS
STATE CORPORATION COMMISSION

WELL PLUGGING RECORD

Give All Information Completely
Make Required Affidavit
Mail or Deliver Report to:
Conservation Division
State Corporation Commission
800 Bitting Building
Wichita, Kansas

Rush County, Sec. 24 Twp. 18 Rge. 16 (E) W. (W)

Location as "NE/CNW/SW" or footage from lines SW SW SE

Lease Owner Ben F. Brack Oil Company, Inc.

Lease Name Rubart Well No. 1

Office Address 309-10 Brown Bldg., Wichita 2, Kansas

Character of Well (completed as Oil, Gas or Dry Hole) Dry hole

Date well completed 9/18 19 50

Application for plugging filed 9/18 19 50

Application for plugging approved 9/18 19 50


Plugging commenced 9/18 19 50

Plugging completed 9/18 19 50

Reason for abandonment of well or producing formation Not commercial production

If a producing well is abandoned, date of last production 19

Was permission obtained from the Conservation Division or its agents before plugging was commenced? Yes - verbally

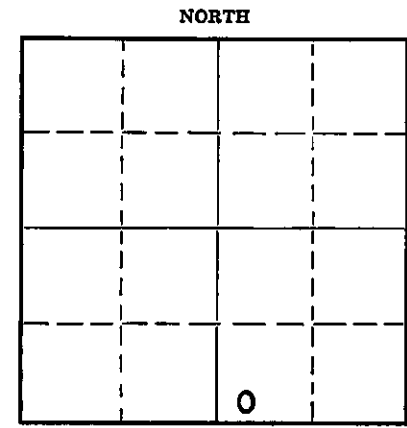

Locate well correctly on above Section Flat

Name of Conservation Agent who supervised plugging of this well C. D. Stough

Producing formation Depth to top Bottom Total Depth of Well 3550 Feet

Show depth and thickness of all water, oil and gas formations.

OIL, GAS OR WATER RECORDS

CASING RECORD

Formation	Content	From	To	Size	Put In	Pulled Out
Surface soil, lime, shale and sandstone		0	9+0 3520	8-5/8 5-1/2	46 jts	2914

Describe in detail the manner in which the well was plugged, indicating where the mud fluid was placed and the method or methods used in introducing it into the hole. If cement or other plugs were used, state the character of same and depth placed, from 3510 feet to 30 feet for each plug set.

Filled hole with chat 3550-3510. Dumped 5 sacks cement.
Pumped 300 sacks bulk cement by Halliburton.
Heavy mud to surface.

RECEIVED
CORPORATION
10-12-50
OCT 12 1950
CONSERVATION DIVISION
WICHITA

(If additional description is necessary, use BACK of this sheet)

Correspondence regarding this well should be addressed to Ben F. Brack Oil Company, Inc.
Address 309-10 Brown Building, Wichita 2, Kansas

STATE OF Kansas, COUNTY OF Sedgwick, ss.
Emil E. Bowers (employee of owner) or (owner or operator) of the above-described well,

being first duly sworn on oath, says: That I have knowledge of the facts, statements, and matters herein contained and the log of the above-described well as filed and that the same are true and correct. So help me God.

BEN F. BRACK OIL COMPANY, INC.
By: Emil E. Bowers
Chief Accountant
309-10 Brown Bldg., Wichita 2, Ks.
(Address)

SUBSCRIBED AND SWORN to before me this 11th day of October 19 50

Notary Public.

My commission expires Nov. 1, 1950

22-7877-8 4-49-10M

PLUGGING
FILE SEC 24 T 18 R 16
BOOK PAGE 2 LINE 30

BEN F. BRACK OIL COMPANY, INC.
 309-10 Brown Building
 Wichita 2, Kansas

Rubart #1

SW SW SE Sec. 24-Twp 18 Rg 16W
 Rush County, Kansas

COMMENCED: June 20, 1950

COMPLETED: September 18, 1950

TOTAL DEPTH: 3550'

DRILLERS LOG

Cellar	5'
Clay Sand & Shells	100
Sand and Gravel	165
Shale and Shells	300
Iron	315
Shale	340
Shale and Clay	390
Dakota Sand	470
Shale, shell & Sand	595
Shale, Shell & Red Bed	760
Red Bed, Iron, Shale	920
Red Bed	931
Anhydrite	970
Red Bed, Shale	1360
Shale and Salt	1675
Shale and B. Lime	1715
Shale and Lime	1840
Shale	2030
Sandy Lime	2115
Lime & Shale	2177
Sandy Lime & Shale	2310
Lime & Shale	2640
Broken Lime & Shale	2725
Shale	2865
Broken Lime	3035
Lime and Shale	3095
Lime	3273
Cherty Lime	3310
Lime Lansing	3340
Lime	3470
Sand	3490
Regan Sand	3500
Regan Sand	3503
Sand	3524
Regan Sand	3527
Sand	3532
Sand Cored	3534
Sand Drilled	3536
Sand cored	3539
Sand cored	3550
TOTAL DEPTH	3550

CASING RECORD:

8-5/8" Surface csg 940'
 5-1/2" Prod.String 3520'

FORMATIONS:

Lansing 3228'
 Sooy 3467'
 Reagan Sand 3495'

RECEIVED
 STATE CORPORATION COMMISSION
 OCT 12 1950
 CONSERVATION DIVISION
 Wichita, Kansas

To the best of my knowledge, the above is a true copy of all formations and where found.

BEN F. BRACK OIL COMPANY, INC.

By: *Emil E. Bowers*
 Chief Accountant

WITNESSED:

Wesley P. Lewis

PLUGGING
 FILE SEC-24T 18 R 16W
 BOOK PAGE 28 LINE 30

Dated: October 11, 1950