

15-165-01804-0000

STATE OF KANSAS
STATE CORPORATION COMMISSION

WELL PLUGGING RECORD


Give All Information Completely
Make Required Affidavit
Mail or Deliver Report to:
Conservation Division
State Corporation Commission
800 Bitting Building
Wichita, Kansas

Rush

County, Sec. 24 Twp. 18S Rge. 16W(E) (W)

Location as "NE/CNWxSWx" or footage from lines NW NW SE
Lease Owner G. L. Reasor
Lease Name Sargent
Office Address 713 Cravens Building, Oklahoma City, Okla.
Character of Well (completed as Oil, Gas or Dry Hole) Dry hole
Date well completed September 8, 1954
Application for plugging filed November 16, 1954
Application for plugging approved
Plugging commenced 9/8/54
Plugging completed
Reason for abandonment of well or producing formation Dry hole

NORTH

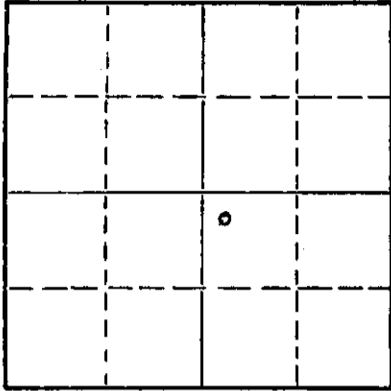

Locate well correctly on above
Section Plat

If a producing well is abandoned, date of last production 19
Was permission obtained from the Conservation Division or its agents before plugging was commenced? Yes

Name of Conservation Agent who supervised plugging of this well Eldon Petty
Producing formation Depth to top Bottom Total Depth of Well 3507 Feet
Show depth and thickness of all water, oil and gas formations.

OIL, GAS OR WATER RECORDS

CASING RECORD

FORMATION	CONTENT	FROM	TO	SIZE	PUT IN	PULLED OUT
Topeka		3075	3087			
Lansing-K C		3223	3228			
Lime		3250	3255			
Oolicast Lime		3296	3304			
Oolitic Lime	S.S.O.	3369	3390			
Reagan Sand	S.S.O.	3468	3493			

Describe in detail the manner in which the well was plugged, indicating where the mud fluid was placed and the method or methods used in introducing it into the hole. If cement or other plugs were used, state the character of same and depth placed, from feet to feet for each plug set.

Ran 80 sacks of cement in top of pipe

(If additional description is necessary, use BACK of this sheet)

Name of Plugging Contractor Sun Oil Well Cementing Company
Address

STATE OF Oklahoma, COUNTY OF Oklahoma, ss.
I. T. Paddleford (employee of owner) or (owner or operator) of the above-described well, being first duly sworn on oath, says: That I have knowledge of the facts, statements, and matters herein contained and the log of the above-described well as filed and that the same are true and correct. So help me God.

(Signature) I. T. Paddleford
713 Cravens Building, Okla. City (Address)

SUBSCRIBED AND SWORN TO before me this 17th day of November, 1954

My commission expires 1/31/57 Seward B. Greuter Notary Public.

PLUGGING
FILE SEC 24 T 18 R 16W
BOOK PAGE 163 LINE 41

11-19-54


15-165-01864-0000

COMPANY G. L. Reasor
 FARM Sargent NO. 1

SEC. 24 T. 18S. 16W
 LOC. NW NW SE

TOTAL DEPTH 3507
 COMM. 8/25/54 COMP. 9/8/54
 SHOT OR TREATED
 CONTRACTOR Anschutz Drilling Co., Inc.
 ISSUED

COUNTY Rush
 KANSAS

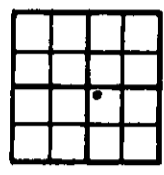

CASING 8-5/8" set at 940 ft. W/450 sacks

20	10
15	8
12	6
13	5

ELEVATION 1925 K.B.

PRODUCTION D&A

FIGURES INDICATE BOTTOM OF FORMATIONS

0 -	15	Surface Soil
15 -	110	Sand
110 -	350	Shale & Shells
350 -	460	Sand (Dakota)
460 -	527	Shale & Shells
527 -	535	Sand
535 -	642	Red Bed
642 -	935	Shale & Red Bed
935 -	943	Anhydrite
943 -	970	Anhydrite
970 -	1120	Red Bed
1120 -	1415	Red Bed & Shale
1415 -	1620	Shale & Shells
1620 -	1865	Shale & Lime
1865 -	2040	Lime & Shale
2040 -	2140	Shale & Lime
2140 -	2360	Lime & Shale
2360 -	2725	Shale & Lime
2725 -	2960	Lime & Shale
2960 -	3023	Shale & Lime
3023 -	3086	Lime & Shale
3086 -	3141	Lime
3141 -	3205	Lime & Shale
3205 -	3222	Lime B. L.
3222 -	3250	Lime Lansing
3250 -	3470	Lime
3470 -	3493	Reagan Sand
3493 -	3507	Sand (Total Depth)

PLUGGING
 SEC 24 T. 18S. 16W
 PAGE 63 LINE 41

11-15-54