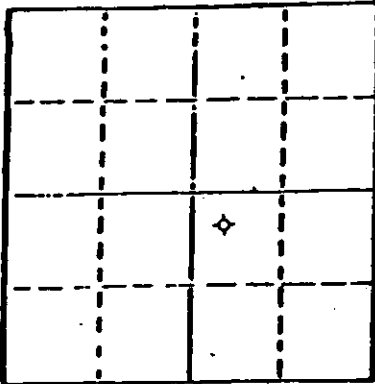


15-165-21097-0000

STATE OF KANSAS
STATE CORPORATION COMMISSION

WELL PLUGGING RECORD

Give All Information Completely
Make Required Affidavit
Mail or Deliver Report to
Conservation Division
State Corporation Comm.
245 North Water
Wichita, KS 67202

Locate well correctly on above
Section Plat

Rush County. Sec. 36 Twp. 19 Rge. 17 E/W
Location as "NE/CNW/SW" or footage from lines
600'/FNL, 330'/FWL, SE4
Lease Owner Dreilling Ltd. of Colorado
Lease Name Folkerts Well No. 1
Office Address 410 - 17th St., Suite 1140, Denver Co. 80202
Character of Well (Completed as Oil, Gas or Dry Hole)

Dry Hole
Date Well completed 6-23 1983
Application for plugging filed 7-6-83 1983
Application for plugging approved 6-23 1983
Plugging commenced 5:30 P.M. 6-23 1983
Plugging completed 7:30 P.M. 6-23 1983
Reason for abandonment of well or producing formation
Not productive

If a producing well is abandoned, date of last production
None 19

Was permission obtained from the Conservation Division or
its agents before plugging was commenced? Yes

Name of Conservation Agent who supervised plugging of this well Bob Tarbutton
Producing formation Depth to top Bottom Total Depth of Well 3850
Show depth and thickness of all water, oil and gas formations.

OIL, GAS OR WATER RECORDS

CASING RECORD

FORMATION	CONTENT	FROM	TO	SIZE	PUT IN	PULLED OUT
				8-5/8	250	None

Describe in detail the manner in which the well was plugged, indicating where the mud fluid was placed and the method or methods used in introducing it into the hold. If cement or other plugs were used, state the character of same and depth placed, from feet to feet for each plug set. Hole full of heavy mud, visc. - 39. Pumped cement through drill pipe as follows:

1st cement plug at 1140' with 50 sacks

2nd cement plug at 630' with 50 sacks

3rd cement plug at 300' with 40 sacks

4th plug with solid hull bridge, 8-5/8" wood and rubber, at 40' with 10 sacks

15 sacks in rathole, 10 sacks in mousehole

175 sacks total 60-40 pozmix with 2% gel, 3% cc

(If additional description is necessary, use BACK of this sheet)

Name of Plugging Contractor Halliburton

STATE OF Colorado COUNTY OF Denver, ss.
Leslie Olson (employee of owner) or (XXXXXX)
of the above-described well, being first duly sworn on oath, says: That I have knowledge of the facts, statements, and matters herein contained and the log of the above-described well as filed and that the same are true and correct. So help me God.

(Signature)

410 - 17th St., Suite 1140, Denver, Co. 80202
(Address)

SUBSCRIBED AND SWORN TO before me this 6th day of July, 1983

Lorraine C. Murphy
Notary Public.

My commission expires 9-2-83

RECEIVED
STATE CORPORATION COMMISSION
7-11-83
JUL 11 1983
CONSERVATION DIVISION
Wichita, Kansas