


STATE OF KANSAS  
STATE CORPORATION COMMISSION

Form CP-4

Give All Information Completely  
Make Required Affidavit  
Mail or Deliver Report to:  
Conservation Division  
State Corporation Commission  
212 No. Market  
Wichita, Kansas

## WELL PLUGGING RECORD

NORTH

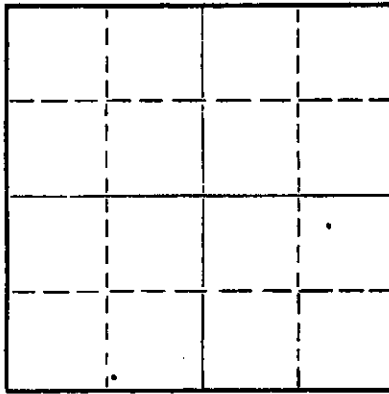

Locate well correctly on above  
Section Plat

Rush County, Sec. 24 Twp. 19 Rge. (E) 18 (W)

Location as "NE/CNW&SW" or footage from lines SW SE SE  
Lease Owner Woodman & Iannitti Drilling Co.  
Lease Name Stueckemann Well No. 1  
Office Address 706 Union Nat'l. Bldg.  
Character of Well (completed as Oil, Gas or Dry Hole) Dry Hole  
Date well completed June 11 19 70  
Application for plugging filed June 11 19 70  
Application for plugging approved June 11 19 70  
Plugging commenced June 11 19 70  
Plugging completed June 11 19 70  
Reason for abandonment of well or producing formation Dry

If a producing well is abandoned, date of last production 19  
Was permission obtained from the Conservation Division or its agents before plugging was commenced? Yes

Name of Conservation Agent who supervised plugging of this well Leo F. Massey  
Producing formation Depth to top Bottom Total Depth of Well 3950 Feet  
Show depth and thickness of all water, oil and gas formations.

## OIL, GAS OR WATER RECORDS

## CASING RECORD

FORMATION	CONTENT	FROM	TO	SIZE	PUT IN	PULLED OUT
				8 5/8	300'	

Describe in detail the manner in which the well was plugged, indicating where the mud fluid was placed and the method or methods used in introducing it into the hole. If cement or other plugs were used, state the character of same and depth placed, from feet to feet for each plug set.

Bottom plug @ 450' w/50sx  
Middle plug @ 300' w/25sx  
Top plug @ 40' w/10sx

RECEIVED  
STATE CORPORATION COMMISSION  
JUN 17 1970  
CONSERVATION DIVISION  
Wichita, Kansas

(If additional description is necessary, use BACK of this sheet)

Name of Plugging Contractor Woodman & Iannitti Drilling Co.  
Address 706 Union Nat'l. Bldg.

STATE OF KANSAS, COUNTY OF SEDGWICK, ss.

K. T. WOODMAN (employee of owner) or (owner or operator) of the above-described well, being first duly sworn on oath, says: That I have knowledge of the facts, statements, and matters herein contained and the log of the above-described well as filed and that the same are true and correct. So help me God.

(Signature)

706 Union Nat'l. Bldg.

(Address)

SUBSCRIBED AND SWORN to before me this 16th day of June, 19 70

My commission expires Feb. 11, 1972

Justina Chamberlain  
Justina Chamberlain

Notary Public.

K. T. WOODMAN  
RES. PHONE AM 5-3572  
OFFICE PH. AM 5-7650  
WICHITA, KANSAS

K-165-20322-0000

D. J. IANNITTI  
TELEPHONE 653-2381  
HOISINGTON, KANSAS

## WOODMAN & IANNITTI DRILLING COMPANY

*Rotary Drilling Contractors*

706 UNION NATIONAL BUILDING

WICHITA, KANSAS 67202

June 16, 1970

Company;	Woodman & Iannitti Drilling Co.
Farm;	No. 1 Stueckemann
Location;	SW SE SE
Section;	24-19-18
County;	Rush
Total Depth;	3950'
Comm;	June 3, 1970
Compl;	June 11, 1970
Casing;	8 5/8 @ 300 w/200 sx
Production;	D & A

Figures Indicate Bottom Of Formations;

185	Rock & Shale
210	Sand
300	Clay & Red Bed
900	Red Bed & Sand
1215	Red Bed
1255	Anhy
1330	Shale, Shells & Salt
1790	Shale
2090	Shale & Lime
2205	Lime
2350	Lime
2445	Lime
2595	Lime
2680	Shale & Lime
2805	Lime
3030	Shale
3245	Shale
3315	Lime & Shale
3380	Lime
3480	Lime
3550	Lime
3590	Lime
3615	Lime & Shale
3679	Lime
3753	Lime
3806	Lime
3860	Lime
3940	Chert & Lime
3950	Total Depth

RECEIVED  
STATE CORPORATION COMMISSION  
JUN 17 1970  
CONSERVATION DIVISION  
Wichita, Kansas

I certify the above to be a true and correct copy of the driller's log and the geological tops to the best of my knowledge and belief.

Woodman & Iannitti Drilling Co.

*K. T. Woodman*  
K. T. Woodman