

15-165-00155-0000


WELL PLUGGING RECORD

Give All Information Completely  
Make Required Affidavit  
Mail or Deliver Report to:  
Conservation Division  
State Corporation Commission  
211 No. Broadway  
Wichita, Kansas

Rush County, Sec. 21 Twp. 19S Rge. (E) 18 (W)

Location as "NE/CNW/SW" or footage from lines NE NE SW  
Lease Owner Leben Drilling, Inc.  
Lease Name Holmes Well No. 1  
Office Address 905 Central Building, Wichita, Kansas  
Character of Well (completed as Oil, Gas or Dry Hole) Dry Hole  
Date well completed January 8 19 57  
Application for plugging filed January 8 19 57  
Application for plugging approved January 8 19 57  
Plugging commenced January 8 19 57  
Plugging completed January 8 19 57  
Reason for abandonment of well or producing formation No Shows

NORTH

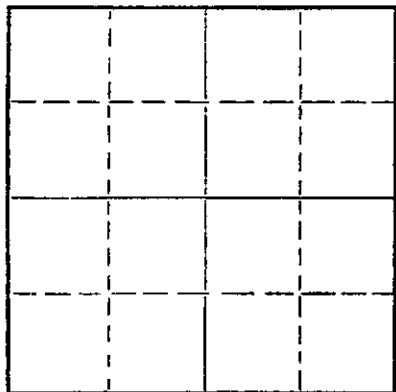

Locate well correctly on above  
Section Plat

If a producing well is abandoned, date of last production \_\_\_\_\_ 19\_\_\_\_  
Was permission obtained from the Conservation Division or its agents before plugging was commenced? Yes

Name of Conservation Agent who supervised plugging of this well R. M. Brundege  
Producing formation \_\_\_\_\_ Depth to top \_\_\_\_\_ Bottom \_\_\_\_\_ Total Depth of Well 4140 Feet  
Show depth and thickness of all water, oil and gas formations.

OIL, GAS OR WATER RECORDS

CASING RECORD

FORMATION	CONTENT	FROM	TO	SIZE	PUT IN	PULLED OUT
				8 5/8	247'	

Describe in detail the manner in which the well was plugged, indicating where the mud fluid was placed and the method or methods used in introducing it into the hole. If cement or other plugs were used, state the character of same and depth placed, from \_\_\_\_\_ feet to \_\_\_\_\_ feet for each plug set.

Bottom plug set at 510' w/1 bbl. of rock and 100 sks. cement through drill pipe - Top plug at 35' w/1/3 sks. hulls and 10 sks. cement to surface.

RECEIVED  
STATE CORPORATION COMMISSION

1-12-57  
CONSERVATION DIVISION

(If additional description is necessary, use BACK of this sheet)

Name of Plugging Contractor Leben Drilling, Inc.  
Address 905 Central Building, Wichita, Kansas

STATE OF Kansas, COUNTY OF Sedgwick, ss.  
Frank Hamlin (employee of owner) ~~(owner or operator)~~ of the above-described well, being first duly sworn on oath, says: That I have knowledge of the facts, statements, and matters herein contained and the log of the above-described well as filed and that the same are true and correct. So help me God.

(Signature) Frank Hamlin  
905 Central Building, Wichita, Kansas  
(Address)

SUBSCRIBED AND SWORN TO before me this 11th day of January, 19 57

My commission expires July 10, 1957

Paul Thomas  
Notary Public.

PLUGGING  
FILE SEC 21 T 19 R 18 W  
BOOK PAGE 132 LINE 29

15-165-00155-0008

CONTRACTOR'S WELL LOG

Leben Drilling, Inc.  
Holmes #1  
NE NE SW of Sec. 21-19S-18W  
Rush County, Kansas

0	50	Surface Rock
50	195	Shale and Shells
195	205	Sand
205	248	Shale and Shells
248	658	Shale and Redbed
658	812	Sand
812	1265	Shale and Redbed
1265	1294	Anhydrite
1294	1320	Shale
1320	1640	Shale and Shells
1640	2045	Shale and Lime
2045	2180	Lime and Shale
2180	2275	Shale and Lime
2275	2565	Lime and Shale
2565	2775	Shale and Lime
2775	2905	Lime and Shale
2905	3050	Shale and Lime
3050	3355	Lime and Shale
3355	3415	Shale and Lime
3415	3455	Lime and Shale
3455	3545	Lime
3545	3580	Lime and Shale
3580	3595	Lime
3595	3890	Lime
3890	4092	Lime and Shale
4092	4140	Arbuckle
	4140	<u>Rotary Total Depth, D &amp; A</u>

COMMENCED: December 27, 1956

COMPLETED: January 8, 1957

SURFACE CASING:

Set 8 5/8" at 247' w/150 sks.  
cement plus 2 sks. Ca. Cl.

State of Kansas )  
County of Sedgwick) ss:

I, Frank Hamlin, do hereby certify that the above and foregoing is a true and correct copy of the log of the Holmes #1, NE NE SW of Section 21-19S-18W, Rush County, Kansas, as reflected by the files of Leben Drilling, Inc..

Frank Hamlin  
Frank Hamlin

Subscribed and Sworn to before me, a Notary Public, in and for Sedgwick County, Kansas, this 11th day of January, 1957.

Jean Thomas  
Notary Public

My commission expires July 10, 1957.

PLUGGING  
FILE SEC 21 T 19 S 18W  
BOOK PAGE 132 L 29

RECEIVED  
STATE CORPORATION COMMISSION

JAN 12 1957  
1-12-57  
CONSERVATION DIVISION  
MANSFIELD, KANSAS