

15-165-00081-0000

STATE OF KANSAS
STATE CORPORATION COMMISSION

WELL PLUGGING RECORD

Give All Information Completely
Make Required Affidavit
Mail or Deliver Report to:
Conservation Division
State Corporation Commission
211 No. Broadway
Wichita, Kansas

Rush County, Sec. 5 Twp. 19S Rge. (E) 18 (W)

Location as "NE/CNW/SW" or footage from lines NW NW SW

Lease Owner Leben Drilling, Inc.

Lease Name Button Well No. 1

Office Address 905 Central Building, Wichita, Kansas

Character of Well (completed as Oil, Gas or Dry Hole) Dry Hole

Date well completed December 24 19 56

Application for plugging filed December 24 19 56

Application for plugging approved December 24 19 56


Plugging commenced December 24 19 56

Plugging completed December 24 19 56

Reason for abandonment of well or producing formation No shows

If a producing well is abandoned, date of last production _____ 19 _____

Was permission obtained from the Conservation Division or its agents before plugging was commenced? Yes

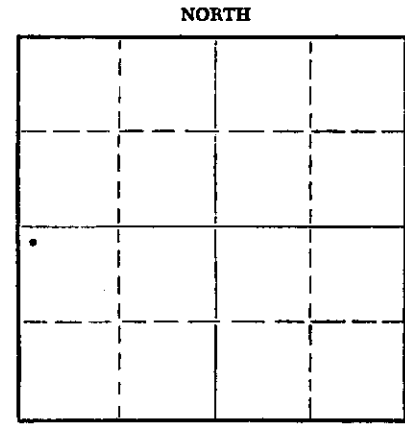

Locate well correctly on above Section Plat

Name of Conservation Agent who supervised plugging of this well R. M. Brundage

Producing formation _____ Depth to top _____ Bottom _____ Total Depth of Well 3945 Feet

Show depth and thickness of all water, oil and gas formations.

OIL, GAS OR WATER RECORDS

CASING RECORD

FORMATION	CONTENT	FROM	TO	SIZE	PUT IN	PULLED OUT
				8 5/8	235'	

Describe in detail the manner in which the well was plugged, indicating where the mud fluid was placed and the method or methods used in introducing it into the hole. If cement or other plugs were used, state the character of same and depth placed, from _____ feet to _____ feet for each plug set.

Bottom plug set at 510' w/100 sks. cement pumped through drill pipe - top plug set at 35' w/10 sks. cement to surface

(If additional description is necessary, use BACK of this sheet)

Name of Plugging Contractor Leben Drilling, Inc.

Address 905 Central Building, Wichita, Kansas

STATE OF Kansas, COUNTY OF Sedgwick, ss.

Frank Hamlin (employee of owner) or (owner or operator) of the above-described well, being first duly sworn on oath, says: That I have knowledge of the facts, statements, and matters herein contained and the log of the above-described well as filed and that the same are true and correct. So help me God.

(Signature) Frank Hamlin

905 Central Building, Wichita, Kansas
(Address)

SUBSCRIBED AND SWORN TO before me this 26th day of December, 19 56

My commission expires July 10, 1957

RECEIVED
STATE CORPORATION COMMISSION

Notary Public.

PLUGGING
FILE SEC 5 T. 19 R. 18W
BOOK PAGE 128 LINE 44

DEC 27 1956
12-27-56
CONSERVATION DIVISION
Wichita, Kansas

CONTRACTOR'S WELL LOG

Leben Drilling, Inc.
 Button #1
 NW NW SW of Sec. 5-19S-18W
 Rush County, Kansas

0	50	Rock
50	235	Shale and Lime
235	625	Shale and Red Bed
625	875	Sand
875	1220	Red Bed
1220	1255	Anhydrite
1255	1405	Shale and Shells
1405	1620	Shale and Lime
1620	1995	Shale
1995	2120	Shale and Lime
2120	2210	Lime and Shale
2210	2335	Lime and Sand
2335	2410	Shale and Lime
2410	2480	Lime and Shale
2480	2615	Lime
2615	2740	Lime and Shale
2740	3025	Shale and Lime
3025	3155	Lime and Shale
3155	3220	Shale and Lime
3220	3310	Lime and Shale
3310	3365	Shale and Lime
3365	3505	Lime and Shale
3505	3513	Shale
3514	3560	Kansas City
3560	3795	Lime
3795	3895	Shale and Lime
3895	3914	Lime
3914	3940	Arbuckle
3940	3945	Arbuckle
	3945	<u>Rotary Total Depth - D & A</u>

COMMENCED: December 13, 1956

COMPLETED: December 24, 1956

SURFACE CASING:

Set 8 5/8" at 235' w/175 sacks
 cement plus 2% Ca. Cl.

State of Kansas)
 County of Sedgwick) ss:


I, Frank Hamlin, do hereby certify that the above and foregoing is a true and correct copy of the log of the Button #1, NW NW SW of Section 5-19S-18W, Rush County, Kansas, as reflected by the files of Leben Drilling, Inc..

Frank Hamlin
 Frank Hamlin

Subscribed and Sworn to before me, a notary public, in and for Sedgwick County, Kansas, this 26th day of December, 1956.

Jean Thomas
 (Notary Public)

My commission expires July 10, 1957.

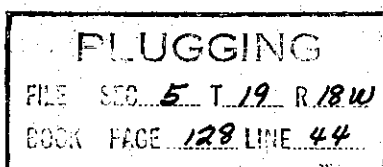

12-27-56