


Give All Information Completely  
Make Required Affidavit  
Mail or Deliver Report to:  
Conservation Division  
State Corporation Commission  
212 North Market, Insurance Bldg.  
Wichita, Kansas

WELL PLUGGING RECORD

Rush

County. Sec. 2 Twp. 19S Rge. 18W (E) (W)

NORTH

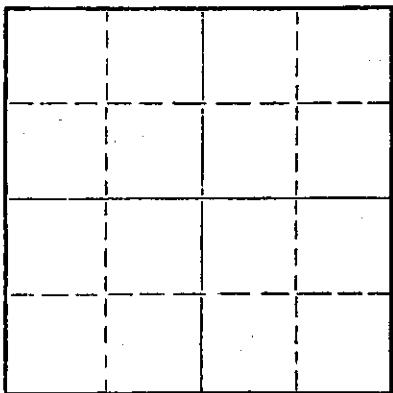

Locate well correctly on above  
Section Plat

Location as "NE/CNW/SW" or footage from lines C NW SE  
Lease Owner Kenneth Rupp  
Lease Name McKay Well No. 1  
Office Address 427 -522- Union Center, Wichita, Kansas  
Character of Well (completed as Oil, Gas or Dry Hole) D & A  
Date well completed April 18, 1961  
Application for plugging filed April 18, 1961  
Application for plugging approved April 18, 1961  
Plugging commenced April 18, 1961  
Plugging completed April 18, 1961  
Reason for abandonment of well or producing formation D & A

If a producing well is abandoned, date of last production 19  
Was permission obtained from the Conservation Division or its agents before plugging was commenced? Yes

Name of Conservation Agent who supervised plugging of this well Eldon Petty  
Producing formation \_\_\_\_\_ Depth to top \_\_\_\_\_ Bottom \_\_\_\_\_ Total Depth of Well \_\_\_\_\_ Feet  
Show depth and thickness of all water, oil and gas formations.

OIL, GAS OR WATER RECORDS

CASING RECORD

FORMATION	CONTENT	FROM	TO	SIZE	PUT IN	PULLED OUT
				8 5/8	346'	-0-

Describe in detail the manner in which the well was plugged, indicating where the mud fluid was placed and the method or methods used in introducing it into the hole. If cement or other plugs were used, state the character of same and depth placed, from \_\_\_\_\_ feet to \_\_\_\_\_ feet for each plug set.

Filled hole with heavy mud to 480'. Set bottom plug with 1/2 sx hulls and 20 sx cement. Set middle plug at 240' with 1/2 sx hulls and 20 sx cement. Filled with heavy mud and set top plug at 35' with 1/2 sx hulls and 10 sx cement.

RECEIVED  
STATE CORPORATION COMMISSION

4-26-61  
APR 26 1961

CONSERVATION DIVISION  
Wichita, Kansas

(If additional description is necessary, use BACK of this sheet)

Name of Plugging Contractor Red Tiger Drilling Company  
Address Box 173 -- Russell, Kansas

STATE OF KANSAS COUNTY OF SEDGWICK, ss.  
George A. Angle (owner or operator) of the above-described well, being first duly sworn on oath, says: That I have knowledge of the facts, statements, and matters herein contained and the log of the above-described well as filed and that the same are true and correct. So help me God.

(Signature)

*George A. Angle*

280 Fourth Nat'l Bank Bldg. Wichita, Ks.  
(Address)

SUBSCRIBED AND SWORN TO before me this 24th day of April, 1961

My commission expires 11-17-62

*Marjorie Head*

Notary Public.

DRILLER'S LOG

No. 1 McKay

CASING RECORD: 8 5/8" @ 346'  
w/210 sx cement

COMPANY: Kenneth Rupp

CONTRACTOR: Red Tiger Drilling Co.

COMMENCED: April 7, 1961

COMPLETED: April 18, 1961

DESCRIPTION: C NW SE  
2-198-18W  
Rush County,  
Kansas

ELEVATION: 2118 DF  
2121 RB

TOTAL DEPTH: 3917'

<u>FORMATION</u>	<u>FROM</u>	<u>TO</u>	<u>REMARKS</u>
Soil	0	05	
Clay & Post Rock	05	30	
Shale & Shells	30	220	
Sand & Shale	220	265	
Shale & Shells	265	620	
Sand	620	780	
Red Bed & Shells	780	1225	
Anhydrite	1225	1263	
Shale	1263	1345	
Shale & Shells	1345	1905	
Shale & Lime	1905	3270	
Lime	3270	3360	
Lime & Shale	3360	3490	
Lime	3490	3893	
Conglomerate	3893	3894	
Lime	3894	3917	

I certify that this is a true and correct copy of the above log to the best of my knowledge.

RED TIGER DRILLING COMPANY

George A. Angle  
George A. Angle

Subscribed and sworn to before me this 24th day of April, 1961.

Marjorie Shad  
Notary Public

My Commission Expires:

11-17-62