

15-165-20862-0000

STATE OF KANSAS  
STATE CORPORATION COMMISSION

FORM CP-4

WELL PLUGGING RECORD

Give All Information Completely  
Make Required Affidavit  
Mail or Deliver Report to  
Conservation Division  
State Corporation Comm.  
245 North Water  
Wichita, KS 67202

Rush County Sec. 19 Twp. 18s Rge. 19 NW  
Location as "NE/CNW/SW" or footage from lines

NE SE

Lease Owner Kimbark Oil and Gas Co.

Lease Name Felder Well No. #1

Office Address 1580 Lincoln Street #700 Denver, Co. 80203

Character of Well (Completed as Oil, Gas or Dry Hole)  
Dry Hole

Date Well completed July 8 19 81

Application for plugging filed July 8 19 81

Application for plugging approved July 8 19 81

Plugging commenced 4:30 A.M. July 8 19 81

Plugging completed 6:00 A.M. July 8 19 81

Reason for abandonment of well or producing formation  
No Commercial Production


If a producing well is abandoned, date of last production  
19

Was permission obtained from the Conservation Division or  
its agents before plugging was commenced? Yes

Name of Conservation Agent who supervised plugging of this well Marion Schmidt

Producing formation Depth to top Bottom Tl. Depth of Well

Show depth and thickness of all water, oil and gas formations.

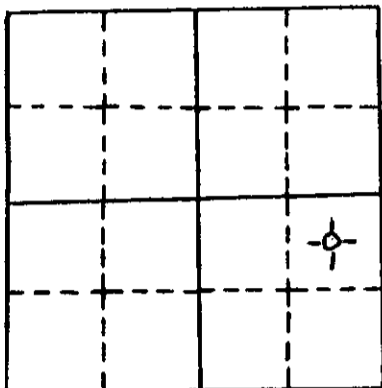

locate well correctly  
on above  
Section Plot

OIL, GAS OR WATER RECORDS

CASING RECORD

FORMATION	CONTENT	FROM	TO	SIZE	PUT IN	PULLED OUT
Surface Casing	common	0'	1062.19'	8 5/8"	1062.19'	0'

Describe in detail the manner in which the well was plugged, indicating where the mud fluid was placed and the method or methods used in introducing it into the hold. If cement or other plugs were used, state the character of same and depth placed, from feet to feet for each plug set.

Plug # 1 1080' with 55 sxs

Plug # 2 240' with 40 sxs

Plug # 3 40' with 10 sxs with solid bridge

5 sxs in rathole

Total 110 sxs 50-50 pos 4% gel 3% cc

P.D. @ 6:00 A.M.

RECEIVED

STATE CORPORATION COMMISSION

7-23-81

JUL 23 1981

CONSERVATION DIVISION

Wichita, Kansas

(If additional description is necessary, use BACK of this sheet)

Name of Plugging Contractor Pioneer Drilling Company Inc.

308 West Mill Plainville, Ks 67663

X STATE OF Colorado COUNTY OF Denver, ss.

Clarence H. Brown (employee of owner) or (owner or operator) of the above described well, being first duly sworn on oath, says: That I have knowledge of the facts, statements, and matters herein contained and the log of the above described well is filed and that the same are true and correct. So help me God.

(Signature) Clarence H. Brown

(Address) 1580 Lincoln Street #700

Denver, Colorado 80203

SUBSCRIBED AND SWORN TO before me this 21st day of July, 19 81

My commission expires 2/2/82

Nancy R. Brueggeman  
Notary Public Nancy R. Brueggeman

WELL LOG

OPERATOR: Kimbark Oil and Gas Co

WELL NAME: Felder #1 LOCATION: NE SE 19 18s 19W

COUNTY: Rush STATE: Kansas

WELL COMMENCED: June 30, 1981 WELL COMPLETED: July 8, 1981

ELEVATION: 2043' K.B. TOTAL DEPTH: 4021'

PRODUCTION: D & A RIG NO: #3


CASING - 8 5/8": 26 Jts. new 24# tallied @ 1055.19' set @ 1062.19' cement with 200 sxs light  
200 sxs common 3/8 cc on both P.D. @ 4:15 P.M. 7-1-81  
 5 1/2": \_\_\_\_\_

ALL MEASUREMENTS TAKEN FROM THE TOP OF ROTARY BUSHING:

FROM	TO	FORMATION	DEVIATION FROM VERTICAL	REMARKS:
0'	383'	sand and shale		
383'	554'	sand and shale		
554'	980'	shale and sand		
980'	1065'	red bed shale	1065' - 1 degree	
1065'	1264'	shale		
1264'	1275'	anhydrite		
1275'	1285'	anhydrite		
1285'	1855'	shale		
1855'	2235'	shale		
2235'	2322'	shale	2322' - 1 degree	
2322'	2355'	shale		
2355'	2530'	shale and lime		
2530'	2790'	shale and lime		
2790'	2997'	shale and lime		
2997'	3183'	lime and shale		
3183'	3405'	lime and shale		
3405'	3570'	lime and shale		
3570'	3680'	lime and shale		
3680'	3806'	lime and shale		
3806'	3908'	lime and shale		
3908'	4000'	lime and shale		
4000'	4021'	lime and shale	4021' - 1 degree	
4021'	R.T.D.			

STATE OF KANSAS  
 COUNTY OF \_\_\_\_\_

The undersigned hereby certifies that to the best of his knowledge and belief, the above facts are true and correct.

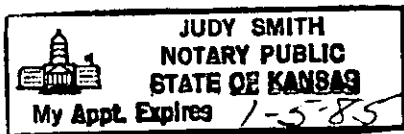

PIONEER DRILLING CO., INC.

By Hacy A. Wilgus

SUBSCRIBED AND SWORN TO, BEFORE ME, This 14<sup>th</sup> day of July, 1981

Judy Smith  
 NOTARY PUBLIC  
 STATE CORPORATION COMMISSION

RECEIVED  
 JUL 23 1981  
 7-23-81  
 CONSERVATION DIVISION  
 Wichita, Kansas