


STATE OF KANSAS
STATE CORPORATION COMMISSION

Give All Information Completely
Make Required Affidavit
Mail or Deliver Report to:
Conservation Division
State Corporation Commission
211 No. Broadway
Wichita, Kansas

WELL PLUGGING RECORD

NORTH

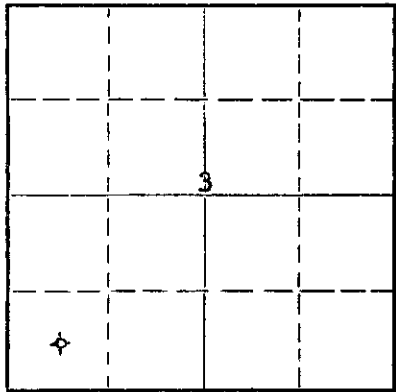

Locate well correctly on above
Section Plat

Finney County, Sec. 3 Twp. 21S Rge. (E) 33 (W)
Location as "NE/CNW/SW" or footage from lines C SW/4 SW/4
Lease Owner A. D. McKelvy
Lease Name Stover Well No. 3
Office Address 48 Lloyd Drive, Atherton, California
Character of Well (completed as Oil, Gas or Dry Hole) dry hole
Date well completed April 3, 19 61
Application for plugging filed May 29, 1961 19 61
Application for plugging approved Approved by supervisor 4/25/ 19 61
Plugging commenced April 25 19 61
Plugging completed April 25 19 61
Reason for abandonment of well or producing formation dry hole

If a producing well is abandoned, date of last production 19
Was permission obtained from the Conservation Division or its agents before plugging was commenced? Yes

Name of Conservation Agent who supervised plugging of this well Frank Broadfoot, St. John, Kansas
Producing formation none Depth to top Bottom Total Depth of Well 2744' Feet
Show depth and thickness of all water, oil and gas formations.

OIL, GAS OR WATER RECORDS

CASING RECORD

FORMATION	CONTENT	FROM	TO	SIZE	PUT IN	PULLED OUT
				5 1/2"	87 jts (2744-33)	29 jts(924.60')

Describe in detail the manner in which the well was plugged, indicating where the mud fluid was placed and the method or methods used in introducing it into the hole. If cement or other plugs were used, state the character of same and depth placed, from feet to feet for each plug set.

Mudded hole to 285', set 10' rock bridge. Mixed and run 20 sacks cement. Mud to 40', set 10' rock bridge, mixed and run 20 sacks cement to base of cellar.

RECEIVED
STATE CORPORATION COMMISSION

MAY 31 1961

CONSERVATION DIVISION
Wichita, Kansas

(If additional description is necessary, use BACK of this sheet)
Name of Plugging Contractor Graham-Michaelis Drilling Company
Address 211 North Broadway, Wichita 2, Kansas

STATE OF Kansas, COUNTY OF Sedgwick, ss.

Jack L. Yinger (employee of owner or operator) of the above-described well, being first duly sworn on oath, says: That I have knowledge of the facts, statements, and matters herein contained and the log of the above-described well as filed and that the same are true and correct. So help me God.

(Signature) Jack L. Yinger
211 North Broadway, Wichita 2, Kansas
(Address)

SUBSCRIBED AND SWORN TO before me this 29 day of May, 19 61

Evelyn D. Evans
Evelyn D. Evans Notary Public.

My commission expires December 12, 1962

