

TYPE

AFFIDAVIT OF COMPLETION FORM

ACO-1 WELL HISTORY

Compt. _____

SIDE ONE

Two (2) copies of this form shall be filed with the Kansas Corporation Commission, 200 Colorado Derby Building, Wichita, Kansas 67202, within thirty (30) days after the completion of a well, regardless of how the well was completed.

F Attach separate letter of request if the information is to be held confidential. If confidential, only file one copy. Information on Side One will be of public record and Side Two will then be held confidential.

Applications must be made on dual completion, commingling, salt water disposal, injection and temporarily abandoned wells.

C Attach one copy only wireline logs (i.e. electrical log, sonic log, gamma ray neutron log, etc.). (Rules 82-2-105 & 82-2-125) KCC# (316) 263-3238.

LICENSE # 7075 EXPIRATION DATE 6/30/84

OPERATOR Anador Resources, Inc. API NO. 15-165-20,866-0000

ADDRESS 5700 South Quebec, Suite 320 COUNTY Rush

Englewood, CO 80111 FIELD Wildcat

** CONTACT PERSON Kent A. Johnson PROD. FORMATION NA

PHONE (303) 741-2886

PURCHASER NA LEASE Keener

ADDRESS WELL NO. 1-21

WELL LOCATION C WN SE

DRILLING Salazar Brothers Drilling 1980 Ft. from East Line and

CONTRACTOR P. O. Box 2958 1980 Ft. from South Line of

ADDRESS Grants, NM 87021 the SE (Qtr.) SEC 21 TWP 19 RGE 18W.

PLUGGING Sun Cementing

CONTRACTOR Great Bend, KS

ADDRESS

TOTAL DEPTH 2344' PBDT 2336'

SPUD DATE 4/8/81 DATE COMPLETED 10/26/83

ELEV: GR 2156' DF -- KB --

DRILLED WITH (CABLE) (ROTARY) (AIR) TOOLS.

DOCKET NO. OF DISPOSAL OR REPRESSURING WELL BEING USED TO DISPOSE OF WATER FROM THIS LEASE --


Amount of surface pipe set and cemented 1324' DV Tool Used? NO

THIS AFFIDAVIT APPLIES TO: (Circle ONE) - Oil, Gas, Shut-in Gas, Dry, Disposal, Injection, Temporarily Abandoned, OWWO. Other

ALL REQUIREMENTS OF THE STATUTES, RULES AND REGULATIONS PROMULGATED TO REGULATE THE OIL AND GAS INDUSTRY HAVE BEEN FULLY COMPLIED WITH.

WELL PLAT

(Office Use Only)

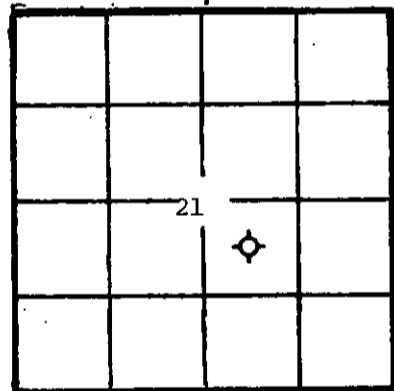

KCC

KGS

SWD/REP

PLG.

A F F I D A V I T

Jerry A. Pope, being of lawful age, hereby certifies that:

I am the Affiant, and I am familiar with the contents of the foregoing Affidavit. The statements and allegations contained therein are true and correct.

Jerry A. Pope
Jerry A. Pope (Name)

SUBSCRIBED AND SWORN TO BEFORE ME this 18th day of November, 1983.

Kris Ann Rosengren
(NOTARY PUBLIC)
Kris Ann Rosengren

MY COMMISSION EXPIRES: 9/15/84

** The person who can be reached by phone regarding any questions concerning this information.

RECEIVED
STATE CORPORATION COMMISSION
NOV 21 1983
11-21-83
CONSERVATION DIVISION
Wichita, Kansas

FILL IN WELL INFORMATION AS REQUIRED:

WELL NO. 1-21

Show all important zones of porosity and contents thereof; cored intervals, and all drill-stem tests, including depth interval tested, cushion used, time tool open, flowing and shut-in pressures, and recoveries.

SHOW GEOLOGICAL MARKERS, LOGS RUN, OR OTHER DESCRIPTIVE INFORMATION.

FORMATION DESCRIPTION, CONTENTS, ETC.	TOP	BOTTOM	NAME	DEPTH
<input checked="" type="checkbox"/> Check if no Drill Stem Tests Run.			Krider Winfield Towanda	2176' 2227' 2286'

If additional space is needed use Page 2, Side 2

Report of all strings set — surface, intermediate, production, etc. CASING RECORD ((New) or (Used))

Purpose of string	Size hole drilled	Size casing set (in O.D.)	Weight lbs/ft.	Setting depth	Type cement	Sacks	Type and percent additives
Surface	9 7/8"	7"	17#	1324'	60-40 POZ	400	3% CaCl
Production	6 1/2"	4 1/2"	10.5#	2337'	Lite 60-40 POZ	275 150	Lomer D.

LINER RECORD

PERFORATION RECORD

Top, ft.	Bottom, ft.	Sacks cement	Shots per ft.	Size & type	Depth interval

TUBING RECORD		
Size	Setting depth	Pecker set at
NONE		

ACID, FRACTURE, SHOT, CEMENT SQUEEZE RECORD

Amount and kind of material used	Depth interval treated
NONE	
Plug with 128 Cu. Ft. of cement from 1400' to surface	

Date of first production	Producing method (flowing, pumping, gas lift, etc.)	Gravity

Estimated Production -I.P.	Oil	Gas	Water %	Gas-oil ratio
	bbls.	MCF	bbls.	CFPB

Disposition of gas (vented, used on lease or sold) _____ Perforations _____