


WELL PLUGGING RECORD

Give All Information Completely
Make Required Affidavit
Mail or Deliver Report to:
Conservation Division
State Corporation Commission
800 Biting Building
Wichita, Kansas

NORTH

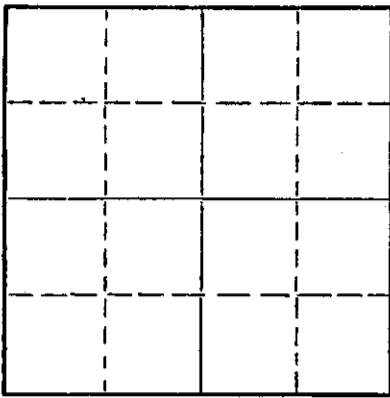

Locate well correctly on above
Section Flat

Harper County. Sec. 31 Twp. 31 Rge. 5 (E) W (W)
Location as "NE/CNW/SW" or footage from lines NE NE NE
Lease Owner Trans Era Petroleum, Inc.
Lease Name Wedman Well No. 1
Office Address Russell, Kansas
Character of Well (completed as Oil, Gas or Dry Hole) Dry Hole
Date well completed 12/27/54 19
Application for plugging filed 12/26/54 19
Application for plugging approved 12/26/54 19
Plugging commenced 12/27/54 19
Plugging completed 12/27/54 19
Reason for abandonment of well or producing formation Dry Hole

If a producing well is abandoned, date of last production _____ 19
Was permission obtained from the Conservation Division or its agents before plugging was commenced? Yes

Name of Conservation Agent who supervised plugging of this well Ruel Durkee
Producing formation _____ Depth to top _____ Bottom _____ Total Depth of Well 4866 Feet
Show depth and thickness of all water, oil and gas formations.

OIL, GAS OR WATER RECORDS

CASING RECORD

FORMATION	CONTENT	FROM	TO	SIZE	PUT IN	PULLED OUT
				8 5/8"	202'	None

Describe in detail the manner in which the well was plugged, indicating where the mud fluid was placed and the method or methods used in introducing it into the hole. If cement or other plugs were used, state the character of same and depth placed, from _____ feet to _____ feet for each plug set.

PLUGGING RECORD

Lay down drill pipe. Filled hole with heavy mud to 200', set first plug at 200' with 15 sacks of cement used. Filled hole with mud to 25', bridge and plug with 5 sacks of cement.

(If additional description is necessary, use BACK of this sheet)

Name of Plugging Contractor Trans Era Petroleum, Inc.
Address Russell, Kansas


STATE OF KANSAS, COUNTY OF RUSSELL, SS.
H. R. Michaelis (employee of owner) or (owner or operator) of the above-described well, being first duly sworn on oath, says: That I have knowledge of the facts, statements, and matters herein contained and the log of the above-described well as filed and that the same are true and correct. So help me God.

(Signature) H. R. Michaelis
Russell, Kansas
(Address)

SUBSCRIBED AND SWORN TO before me this 7th day of January, 19 55

My commission expires 1-30-57

Margie Cooper
Notary Public.

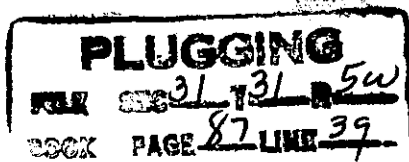

01-08-1955
CONSERVATION DIVISION
WICHITA, KANSAS

15-077-00145-00-00

Trans Era Petroleum &
Aurora Gasoline Co.

NE NE NE 31-31-5
Harper County, Ks.

Wellman #1
Total Depth: 4866'
Comm. 12/3/54
Comp. 12/27/54

Contractor: Trans Era Petroleum, Inc.

Casing

Cement

8 5/8" Set @ 202'

165 sacks Portland

FORMATION	DEPTH
Soil	20
Sand	30
Shale-sand	120
Red bed	385
Shale-shells	680
Salt	775
Shale-shells	985
Anhydrite	1015
Anhydrite-shale	1130
Shale-shells	1185
Shale-line	2025
Shale	2150
Shale-line	2280
Shale-line-shells	2430
Shale-line	3645
Line	3810
Line-shale	4220
Shale-chert	4249
Line-chert	4289
Line-shale	4315
Chert-line	4350
Line	4560
Line-shale	4625
Shale	4690
Sand	4706
Sand-line	4740
Sand-shale	4840
Shale-line	4858
Line	4866'

STATE OF KANSAS }
RUSSELL COUNTY } ss

I hereby certify that the above information is true and correct to the best of my knowledge.

01-08-1955

Paul R. [Signature]

Subscribed and sworn to before me this 5th day of January, 1955.

Margie Cooper
Notary Public

My commission expires: 1-30-57.

