


Give All Information Completely
Make Required Affidavit
Mail or Deliver Report to:
Conservation Division
State Corporation Commission
800 Biting Building
Wichita, Kansas

WELL PLUGGING RECORD

Harper County, Sec. 30 Twp. 31S Rge. 5 ~~23~~ W (W)

Location as "NE/CNW/SW" or footage from lines NE NE NE
Lease Owner Gene Goff
Lease Name Moritz Well No. 1
Office Address Stanolind Bldg., Tulsa, Oklahoma
Character of Well (completed as Oil, Gas or Dry Hole) Dry Hole
Date well completed March 6 19 56
Application for plugging filed March 6 19 56
Application for plugging approved March 6 19 56
Plugging commenced March 6 19 56
Plugging completed March 6 19 56
Reason for abandonment of well or producing formation Dry

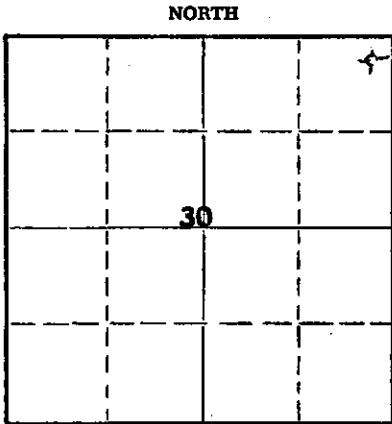

Locate well correctly on above
Section Plat

If a producing well is abandoned, date of last production _____ 19____
Was permission obtained from the Conservation Division or its agents before plugging was commenced? Yes

Name of Conservation Agent who supervised plugging of this well M. A. Rives, Pratt, Kansas
Producing formation none Depth to top _____ Bottom _____ Total Depth of Well 4850 Feet
Show depth and thickness of all water, oil and gas formations.

OIL, GAS OR WATER RECORDS

CASING RECORD

FORMATION	CONTENT	FROM	TO	SIZE	PUT IN	PULLED OUT

Describe in detail the manner in which the well was plugged, indicating where the mud fluid was placed and the method or methods used in introducing it into the hole. If cement or other plugs were used, state the character of same and depth placed, from _____ feet to _____ feet for each plug set.

Hole filled with heavy drilling mud; placed one sack of fiber seal at 200', then ran 20 sacks of cement through drill pipe on top of fiber seal. Placed 1/2 sack fiber seal at 28' and filled to top of surface pipe with 10 sacks cement. Cut off surface pipe at bottom of cellar.

(If additional description is necessary, use BACK of this sheet)

Name of Plugging Contractor Graybel Oil Corporation
Address 425 National Bank of Tulsa Bldg., Tulsa, Oklahoma


STATE OF Oklahoma, COUNTY OF Tulsa, ss.
_____(employee of owner) or (owner or operator) of the above-described well, being first duly sworn on oath, says: That I have knowledge of the facts, statements, and matters herein contained and the log of the above-described well as filed and that the same are true and correct. So help me God. GENE GOFF

(Signature) Robert E. Brangley BY: Robert E. Brangley
421 Stanolind Building, Tulsa, Okla.
(Address)

SUBSCRIBED AND SWORN TO before me this 6th day of March, 1956

My commission expires February 2, 1960

Gene Maloney
Notary Public.

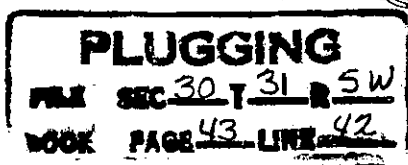

REC
STATE OF KANSAS
MARCH 1956
CONSULT

15-077-06225-00-00

GENE GOFF

HARPER COUNTY, KANSAS

MORITZ NO. 1

NE NE NE

Sec. 30, Twp. 31S, Rge. 5W

CONTRACTOR: GRAYBOL OIL CORP. (Rig No. 3) Rotary Tools
425 National Bank of Tulsa Bldg., Tulsa, Okla.

Elevation: 1364 D.F.

Commenced: 2-11-56

Production: D. & A.

Completed: 3-6-56

CASING RECORD

Run
206' of 8 5/8" cemented w/135 sacks.

Pulled
None

DEPTH	STRATA	FORMATION TOPS	DEPTH
0 - 440	Surface	Stalnaker	3598'
440 - 1040	Shale, Red beds and lime	Lansing	3744
1040 - 1430	Lime and shale	Mississippi	4214
1430 - 1595	Lime and sand	Chattanooga	4582
1595 - 1715	Lime	Simpson	4690
1715 - 2050	Lime and shale	Arbuckle	4806
2050 - 2220	Shale and lime		
2220 - 2345	Lime and shale		
2345 - 2455	Shale and lime		
2455 - 2550	Shale, lime and sand		
2550 - 2655	Lime and sand		
2655 - 2748	Lime and shale		
2748 - 2780	Shale and lime		
2780 - 2895	Lime, shale and sand		
2895 - 3150	Lime and shale		
3150 - 3310	Shale		
3310 - 3445	Shale and sand		
3445 - 3620	Shale		
3620 - 3720	Lime		
3720 - 3745	Sandy lime and lime		
3745 - 3820	Lime		
3820 - 3848	Shale and lime		
3848 - 3918	Lime and shale		
3918 - 3988	Lime		
3988 - 4038	Lime and shale		
4038 - 4080	Shale and lime		
4080 - 4145	Lime		
4145 - 4207	Lime and shale		
4207 - 4242	Shale and lime		
4242 - 4559	Lime		
4559 - 4573	Shale and lime		
4573 - 4600	Lime and shale		
4600 - 4684	Shale		
4684 - 4690	Cored		
4690 - 4715	Sand		
4715 - 4738	Sand and shale		
4738 - 4817	Sand		
4817 - 4850	Sand and lime		
Total depth 4850'			

Drill-stem Tests:

No. 1, 4210 - 4242. Tool open 1 hour. Weak blow throughout test. Recovered 65' mud.

No. 2, 4682 - 4690. Tool open 3/4 hr. Recovered 940' muddy salt water. I.F.P. 0#, F.F.P. 400#, B.H.P. 1800# shut in 15 min.

CORES:

No. 1, 4684 - 4690, Recovered 5'

I hereby certify that the above is a true and correct log of said well as reflected by the daily drilling reports.

GRAYBOL OIL CORPORATION

By: *Jack Cole*
Jack Cole, Geologist

STATE OF OKLAHOMA, COUNTY OF TULSA, ss
Subscribed and sworn to before me this 9th day of March, 1956.

Michael J. Garton
Notary Public

My commission expires July 21, 1958.

PLUGGING
FILE SEC 30 T 31 SW
BOOK PAGE 43 LINE 42

03-14-1956