


STATE OF KANSAS
STATE CORPORATION COMMISSION

Give All Information Completely
Make Required Affidavit
Mail or Deliver Report to:
Conservation Division
State Corporation Commission
211 No. Broadway
Wichita, Kansas

15-077-00073-00-00

WELL PLUGGING RECORD

NORTH

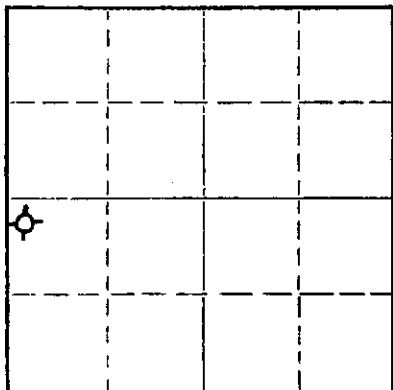

Locate well correctly on above
Section Plat

Harper County, Sec. 29 Twp. 31S Rge. 5 (E) W (W)
Location as "NE/CNWSW" or footage from lines NW NW SW
Lease Owner Walters Drilling Co. & BOA
Lease Name Van Valkenburg Well No. 1
Office Address 510 Orpheum Building, Wichita, Kansas
Character of Well (completed as Oil, Gas or Dry Hole) Dry Hole
Date well completed February 14, 19 60
Application for plugging filed February 14, 19 60
Application for plugging approved Verbal approval obtained Feb. 14 19 60
Plugging commenced February 14, 1960 19
Plugging completed February 14, 1960 19
Reason for abandonment of well or producing formation

If a producing well is abandoned, date of last production 19
Was permission obtained from the Conservation Division or its agents before plugging was commenced? Yes

Name of Conservation Agent who supervised plugging of this well Fred Hampel
Producing formation None Depth to top Bottom Total Depth of Well Feet
Show depth and thickness of all water, oil and gas formations.

OIL, GAS OR WATER RECORDS

CASING RECORD

FORMATION	CONTENT	FROM	TO	SIZE	PUT IN	PULLED OUT
None	None	0'	225'	8-5/8"	218'	None
	No oil string					

Describe in detail the manner in which the well was plugged, indicating where the mud fluid was placed and the method or methods used in introducing it into the hole. If cement or other plugs were used, state the character of same and depth placed, from feet to feet for each plug set.

Set bottom plug @ 210' with hulls and 18 sacks cement thru drill pipe
Set top plug @ 40' with hulls and 10 sacks cement

RECEIVED
STATE CORPORATION COMMISSION

FEB 23 1960

CONSERVATION DIVISION
Wichita, Kansas

02-23-1960

(If additional description is necessary, use BACK of this sheet)

Name of Plugging Contractor Walters Drilling Co.
Address 510 Orpheum Building, Wichita, Kansas

STATE OF KANSAS, COUNTY OF SEDGWICK, ss.
Robert F. Walters (Employer/Operator) of the above-described well, being first duly sworn on oath, says: That I have knowledge of the facts, statements, and matters herein contained and the log of the above-described well as filed and that the same are true and correct. So help me God.

(Signature) Robert F. Walters
510 Orpheum Building, Wichita, Kansas
(Address)

SUBSCRIBED AND SWORN TO before me this 19th day of February 19 60

R. L. Abel
Notary Public.

My commission expires January 4, 1964





VAN VALKENBURG NO. 1

Location: NW NW SW Sec. 29-31S-5W Date Spudded: 1/29/60
 Harper County, Kansas
 Operator: Walters Drilling Co. Rotary Completion: 2/14/60
 Contractor: Walters Drilling Co. Elevation: 1349 GR
 1352 DF
 Surface Casing: 8-5/8" set @ 225' 1354 KB
 with 175 sacks cement
 Oil String: None

LOG
 (Figures indicate bottom of formation)


Surface	0 to 225
Redbed-shale	650
Shale and shells	950
Shale & lime	1555
Lime	1690
Shale & lime	2815
Shale, sand & lime	2920
Shale & lime	3337
Sand	3442
Shale & lime	3650
Lime	3834
Shale & lime	4215
Sand	4232
Lime	4234
Sand	4264
Lime	4578
Shale & lime	4696
Sand	4719
Total Depth	4719

RECEIVED
 STATE GEOLOGICAL SURVEY
 MISSION
 FEB 23 1960
 CONSERVATION DIVISION
 Wichita, Kansas
 02-23-1960

The undersigned, Robert F. Walters, hereby certifies that the above log is a true and correct log of the formations encountered in drilling the above noted well as reflected by the Daily Drilling Reports.

WALTERS DRILLING CO.

By

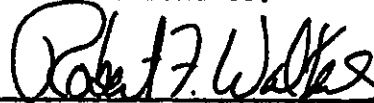

Subscribed and sworn to before me
 this 19th day of February, 1960


 Notary Public